

TYPICAL BAY LEVELS 1 TO 20 EAST & WEST ELEVATION
40 OFF - TYPE 10



NOTE; DUE TO BUILD TOLERANCE OF EXISTING BUILDING OPENING WINDOWS MAY INTERFERE WITH SITUATIONS WHERE TENANT HAS CHOSEN TO INFILL HATCH. SETTING OUT FAVOURS OPENING ON KITCHEN SIDE = PREFERABLE.

STUDIO E ARCHITECTS		
PALACE HARF RAINVILLE ROAD LONDON W8 0RN		
<input checked="" type="checkbox"/>	Conforms to Design Intent	
<input type="checkbox"/>	Conforms to Design Intent subject to incorporation of comments. Revise and re-submit for category 'A' status.	
<input type="checkbox"/>	Does not conform with Design Intent. Revise and re-submit.	
Note		
Drawing status is given for conformity with our Design Intent only and does not relieve the contractor/sub-contractor/trade contractor from responsibility for their design accuracy and integration.		
Comments made do not automatically constitute variation. Refer to separate specification clause for supplementary information regarding drawing status.		
Date	Checked By Signature	Name (Print)
16/01/15		NSC
Date	Authorised Signature	Name (Print)

APPROVED FOR
CONSTRUCTION

FILE 855..

Rev	Date	Notes
E	14.01.15	CONSTRUCTION
D	27.10.14	ALL WIDTHS & HEIGHT
C	25.09.14	ACM JOINT, LI REVERSED, T.VENT
B	22.09.14	FRAME WIDTHS
A	29.08.14	JOINTS


Description:	ELEVATIONS
Project:	GRENFELL TOWER GRENFELL RD, LONDON. W11 1TQ

Drawn By:	bd KVL	Date:	20.08.14	Scale:	1:30@A3
-----------	--------	-------	----------	--------	---------

HARLEY HOUSE BROOKLANDS PARK FARNINGHAM ROAD CROWBOROUGH EAST SUSSEX TN6 2JD Tel: [REDACTED]	

Drawing No:	Rev:
C1059-200	E

MINIMUM VENT PANEL SIZE TO BE CONFIRMED BY RYDON

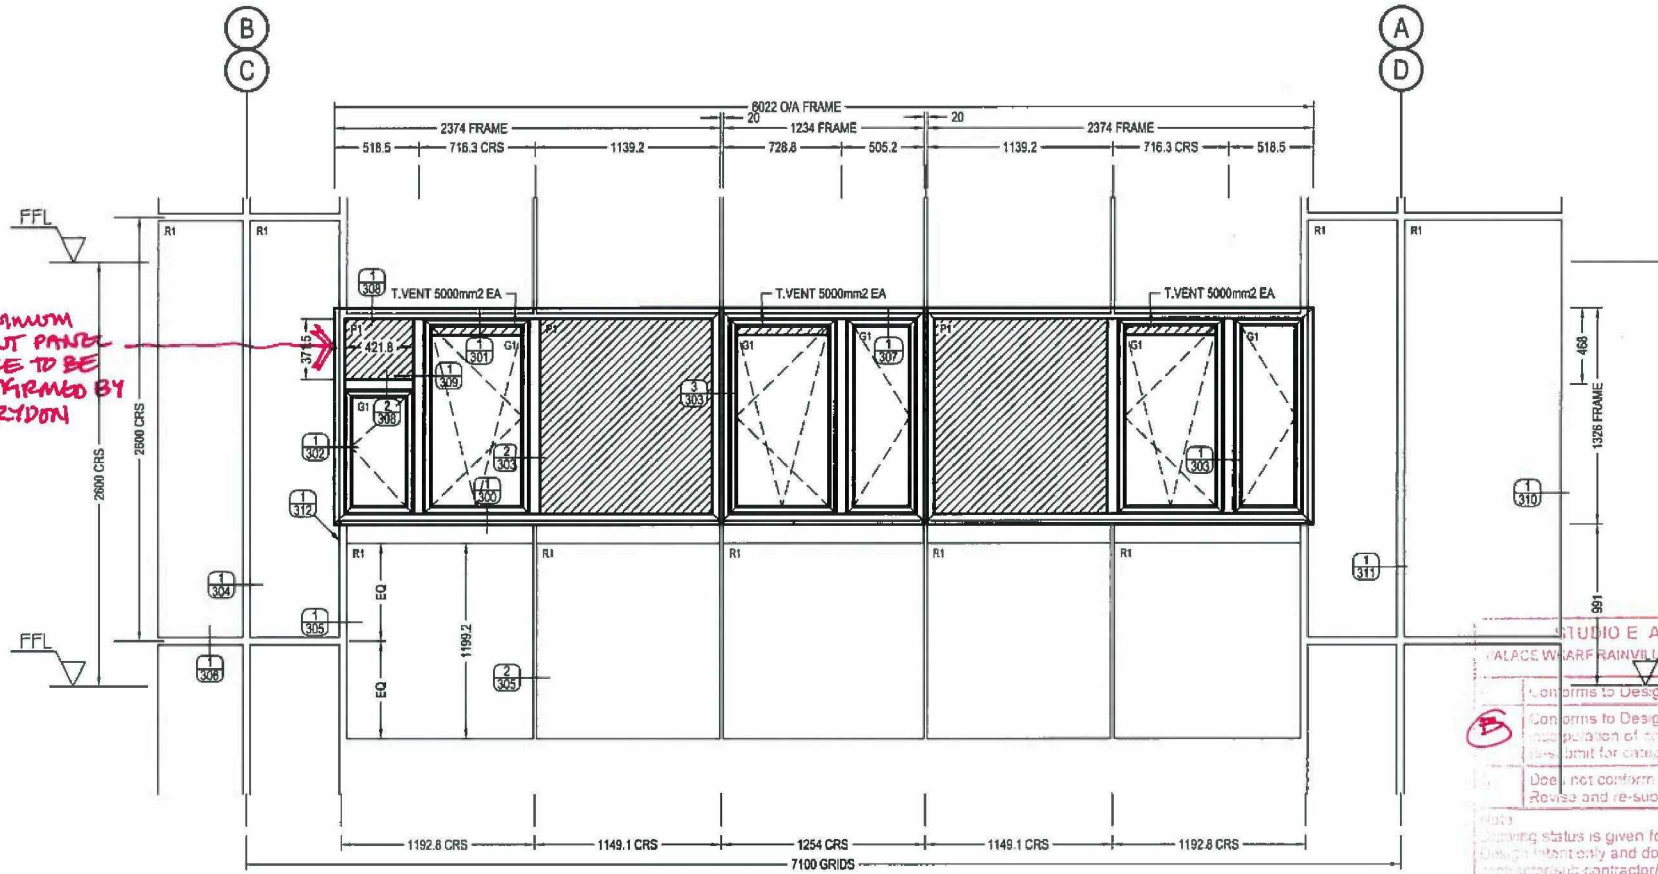

TYPICAL BAY LEVELS 1 TO 20 WEST / EAST ELEVATION
 (EAST / WEST IS OPPOSITE HAND)
 40 OFF AS DRAWN - TYPE 11as
 40 OFF OPP HAND - TYPE 11opp

STUDIO E ARCHITECTS
 PALACE WHARF RAINVILLE ROAD LONDON W6 9BN

Conforms to Design Intent

B Conforms to Design Intent subject to incorporation of comments. Revise and resubmit for category 'A' status

Does not conform with Design Intent. Revise and re-submit


Note:
 Drawing status is given for conformity with outline Design Intent only and does not relieve the architect/sub-contractor/trade contractor from their responsibility for their design accuracy and integration.
 Comments made do not automatically constitute variation. Refer to separate specification clause for supplementary information regarding drawing status.

Date	Checked By Signature	Name (Print)
16/01/15		NSC
Date	Authorised Signature	Name (Print)

APPROVED FOR CONSTRUCTION

FILE 865..	-	-	-	Description: ELEVATIONS	Project: GRENFELL TOWER GRENFELL RD, LONDON. W11 1TQ	Drawn By: bd KVL	Date: 22.09.14	Scale: 1:30@A3	HARLEY HOUSE BROOKLANDS PARK FARNINGHAM ROAD CROWBOROUGH EAST SUSSEX TN6 2JD Tel:	Drawing No: C1059-201	Rev: B
	B	14.01.15	CONSTRUCTION								
	A	25.09.14	ACM JOINTS, LI REVERSED								
	Rev	Date	Notes								

SEA00003040/2

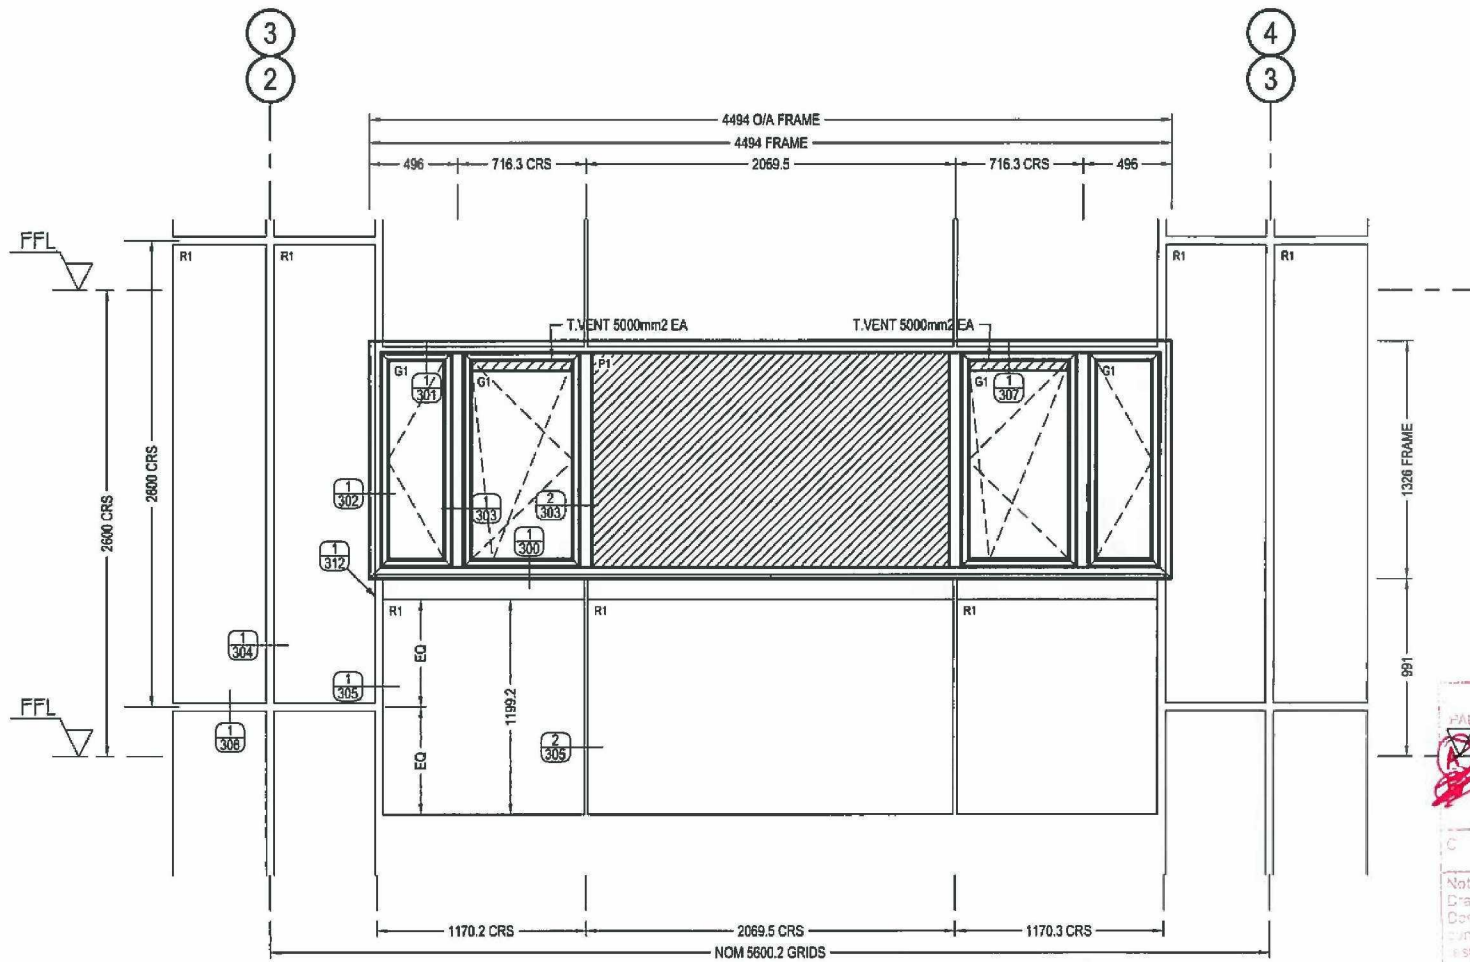

TYPICAL BAY LEVELS 1 TO 20 SOUTH ELEVATION
160 OFF - TYPE 1

STUDIO E ARCHITECTS
FALMOUTH HARF RAINVILLE ROAD LONDON LONDON

Confirms to Design Intent

Confirms to Design Intent subject to incorporation of comments. Revise and re-submit for category 'A' status.

Does not conform with Design Intent. Revise and re-submit.

Note:
Drawing status is given for conformity with outline Design Intent only and does not relieve the contractor/sub-contractor/trade contractor from their responsibility for their design accuracy and integration.
Comments made do not automatically constitute a variation. Refer to separate specification clause for supplementary information regarding drawing status.

Date	Checked By Signature	Name (Print)
16/01/15		MSC
Date	Authorised Signature	Name (Print)

APPROVED FOR CONSTRUCTION

FILE 855.

Rev	Date	Notes
B	13.01.15	REDRAWN
A	25.09.14	ACM JOINTS

Description: ELEVATIONS

Project: GRENFELL TOWER
GRENFELL RD, LONDON, W11 1TQ


Drawn By: bd KVL Date: 22.09.14 Scale: 1:30@A3

harley
HARLEY HOUSE
BROOKLANDS PARK
FARNINGHAM ROAD
CROWBOROUGH
EAST SUSSEX
TN6 2JD
Tel: [REDACTED]

Drawing No: C1059-202 Rev: B

DRG NOT REQD.

? OLD VERSION OF THIS BAY

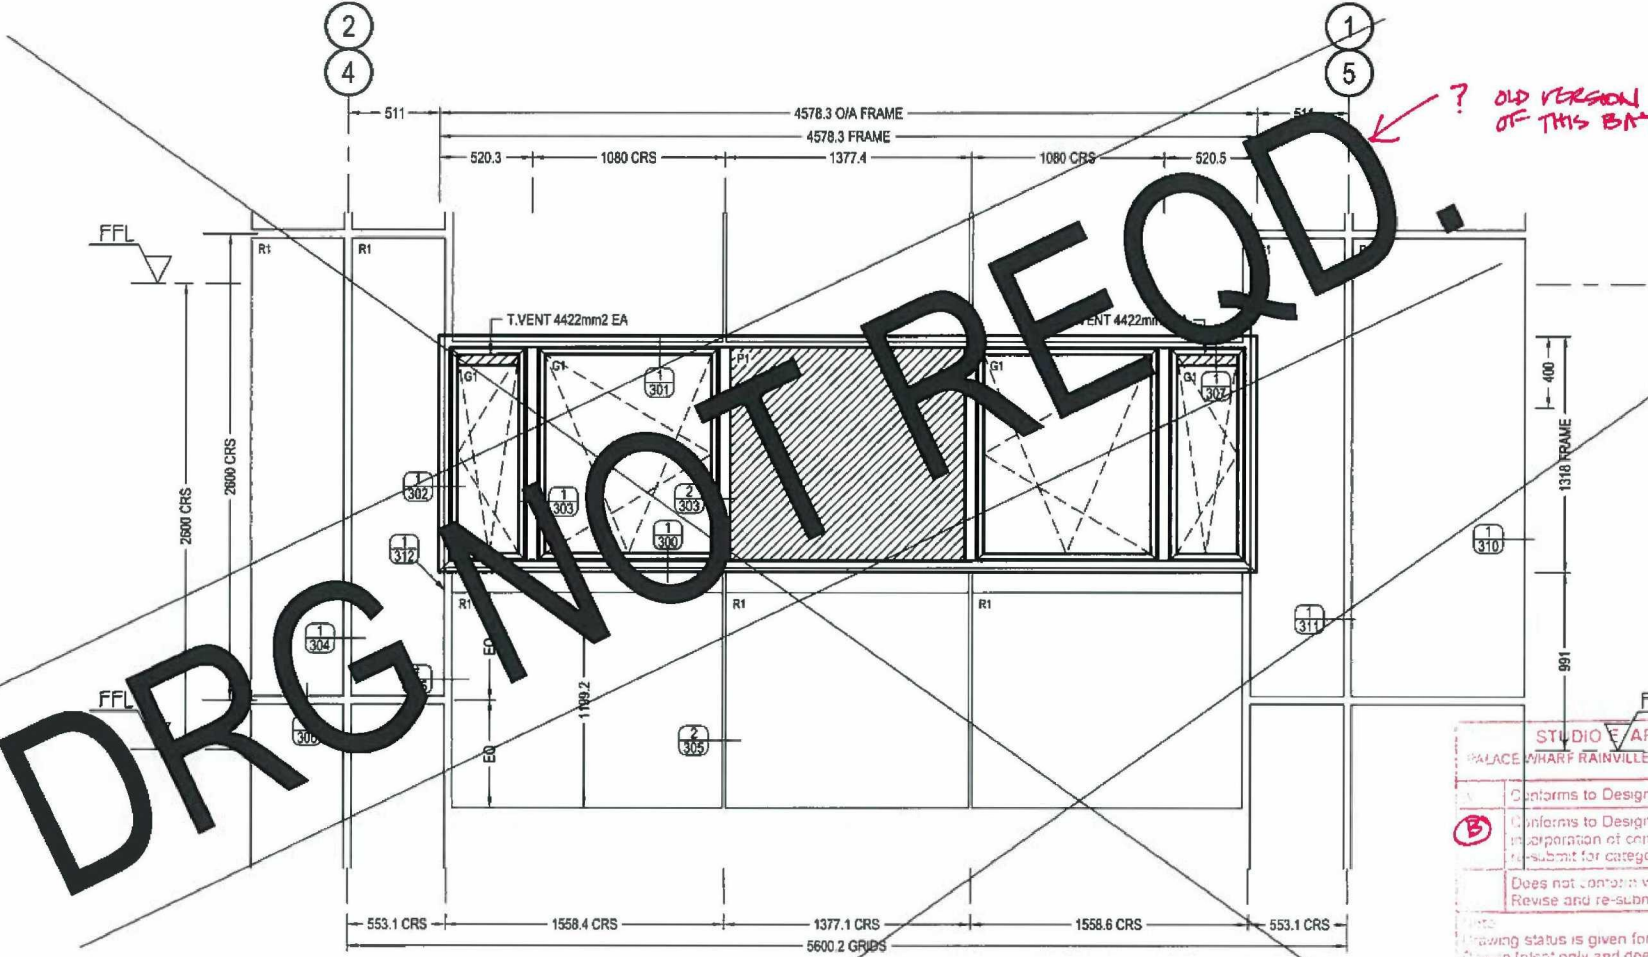


TYPICAL BAY LEVELS 1 TO 20 SOUTH / NORTH ELEVATION
(NORTH / SOUTH IS OPPOSITE HAND)

STUDIO ARCHITECTS		
PALACE WHARF RAINVILLE ROAD LONDON W5 5HN		
<input type="checkbox"/>	Conforms to Design Intent	
<input checked="" type="checkbox"/>	Conforms to Design Intent subject to incorporation of comments. Revise and re-submit for category 'A' status	
<input type="checkbox"/>	Does not conform with Design Intent. Revise and re-submit!	
<p>NOTE</p> <p>Drawing status is given for conformity with our Design Intent only and does not relieve the contractor/sub-contractor/trade contractor from their responsibility for their design accuracy and completion.</p> <p>Comments made do not automatically constitute a variation. Refer to separate specification clause for supplementary information regarding drawing status.</p>		
Checked By	Signature	Name (Print)
NSC		16/01/15
Authorised	Signature	Name (Print)

FILE 855..	-		Description: ELEVATIONS	Project: GRENFELL TOWER GRENFELL RD, LONDON. W11 1TQ	Drawn By: bd KVL	Date: 22.09.14	Scale: 1:30@A3	HARLEY HOUSE BROOKLANDS PARK FARNINGHAM ROAD CROWSBOROUGH EAST SUSSEX TN6 2JD Tel: [REDACTED]	Drawing No. C1059-203	Rev: B	
	B	14.01.15									NOT REQUIRED
	A	25.09.14									ACM JOINTS
	Rev	Date									Notes

SEA00003040/4

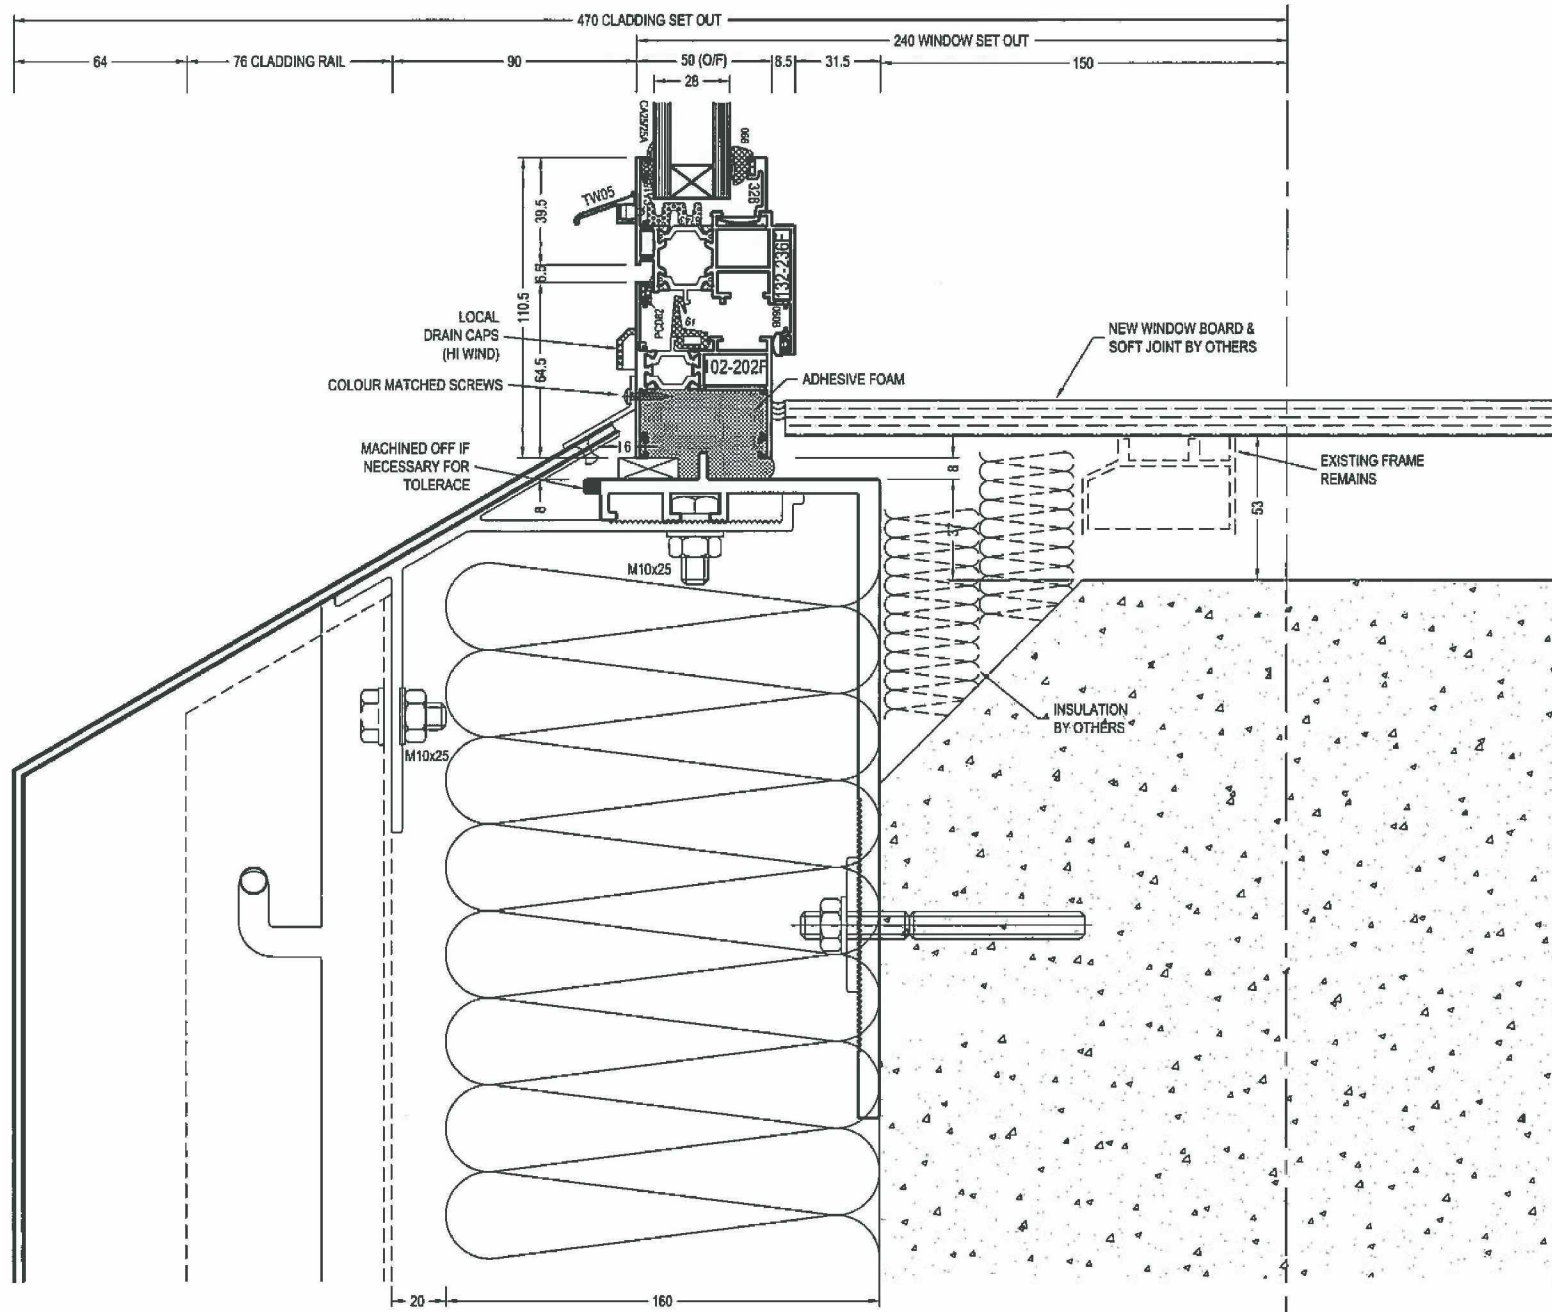

①
WINDOW CILL
UPPER LEVELS

STUDIO E ARCHITECTS
PALACE WHARF RAINVILLE ROAD LONDON W9 0HN

Conforms to Design Intent

Conforms to Design Intent subject to incorporation of comments. Revise and re-submit for category 'A' status.

Does not conform with Design Intent. Revise and re-submit

Note:
Drawing status is given for conformity with outline Design Intent only and does not relieve the contractor/sub-contractor/trade contractor from their responsibility for their design accuracy and integration.
Comments made do not automatically constitute variation. Refer to separate specification clause for supplementary information regarding drawing status.

Date	Checked By Signature	Name (Print)
NSC		16/01/15
172	Authorised Signature	Name (Print)

APPROVED FOR
CONSTRUCTION


FILE 865.

Rev	Date	Notes
E	13.01.15	CONSTRUCTION
D	25.11.14	SHELF ANGLE POSITION
C	28.10.14	WINDOW DROPPED 20MM
B	25.09.14	FRAME PACKING
A	29.08.14	NOTES ADDED, PANEL SET OUT+20

Description	Project
SECTIONS	GRENFELL TOWER GRENFELL RD, LONDON, W11 1TQ

Drawn By: bd KVL	Date: 20.08.14	Scale: 1:2@A3
---------------------	-------------------	------------------

HARLEY HOUSE BROOKLANDS PARK FARNINGHAM ROAD CROWBOROUGH EAST SUSSEX TN6 2JD Tel:	Drawing No:	Rev:
	C1059-300	E

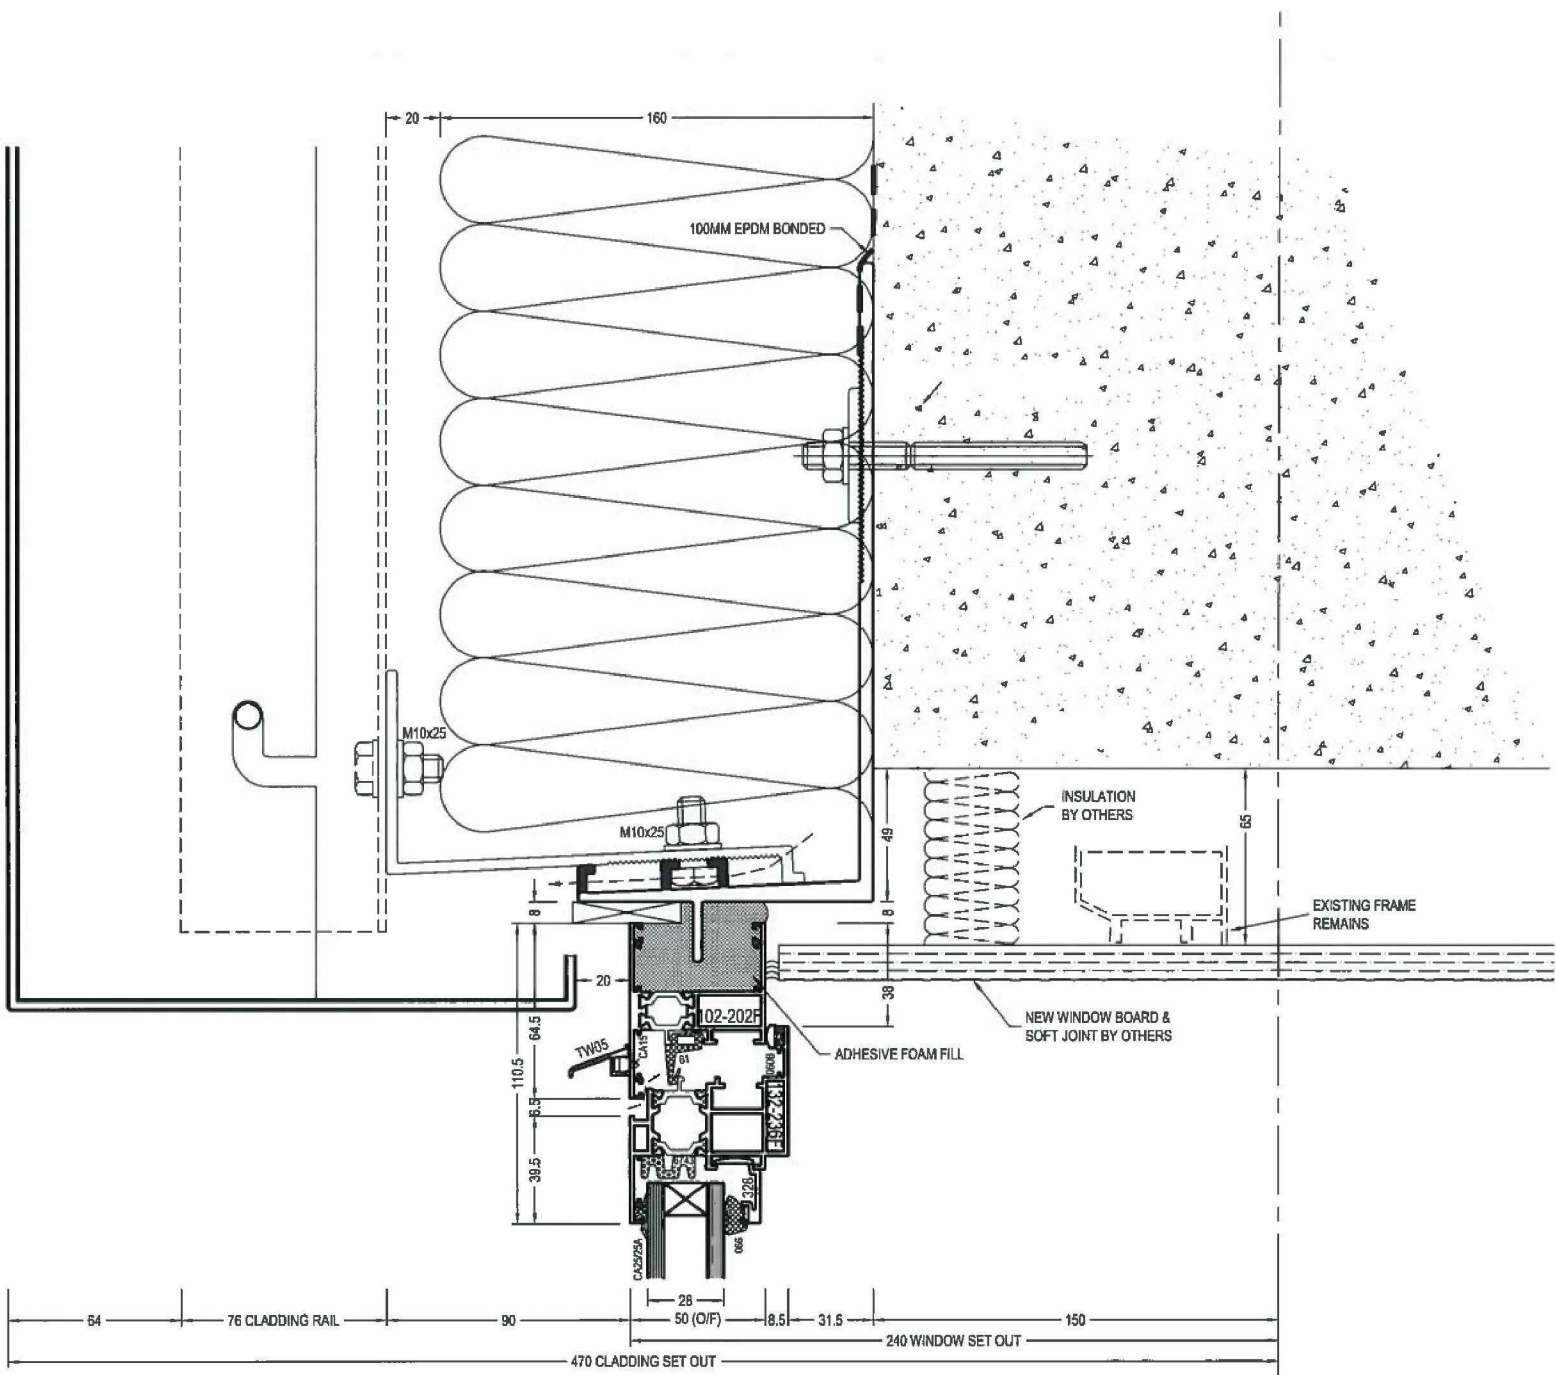

①
WINDOW HEAD
UPPER LEVELS

STUDIO E ARCHITECTS	
PALACE WHARF RAINVILLE ROAD LONDON E14 9HT	
A	Conforms to Design Intent
B	Conforms to Design Intent subject to incorporation of comments. Revise and re-submit for category A status
C	Does not conform with Design Intent. Revise and re-submit

Note:
Drawing status is given for conformity with our Design Intent only and does not relieve the architect/sub-contractor/trade contractor from responsibility for their design accuracy and integration.
Comments made do not automatically constitute variation. Refer to separate specification clause for supplementary information regarding drawing status.

Date	Checked By	Name (Print)
16/6/15	[Signature]	NBC
Date	Authorised	Name (Print)
	Signature	

**APPROVED FOR
CONSTRUCTION**




FILE 855.	D	13.01.15	CONSTRUCTION
	C	25.11.14	SHelf ANGLE POSITION
	B	128.10.14	WINDOW RAISED 20MM
	A	29.08.14	DIM ADDED, PANEL SET OUT +20
	Rev	Date	Notes

SECTIONS

Project:		
GRENfell TOWER GRENfell RD, LONDON, W11 1TQ		
Drawn By:	Date:	Scale:
bd KVL	20.08.14	1:2@A3

 HARLEY HOUSE BROOKLANDS PARK FARNINGHAM ROAD CROWBOROUGH EAST SUSSEX TN6 2JD Tel: [Redacted]	Drawing No:	Rev:
	C1059-301	D

SEA00003040/6

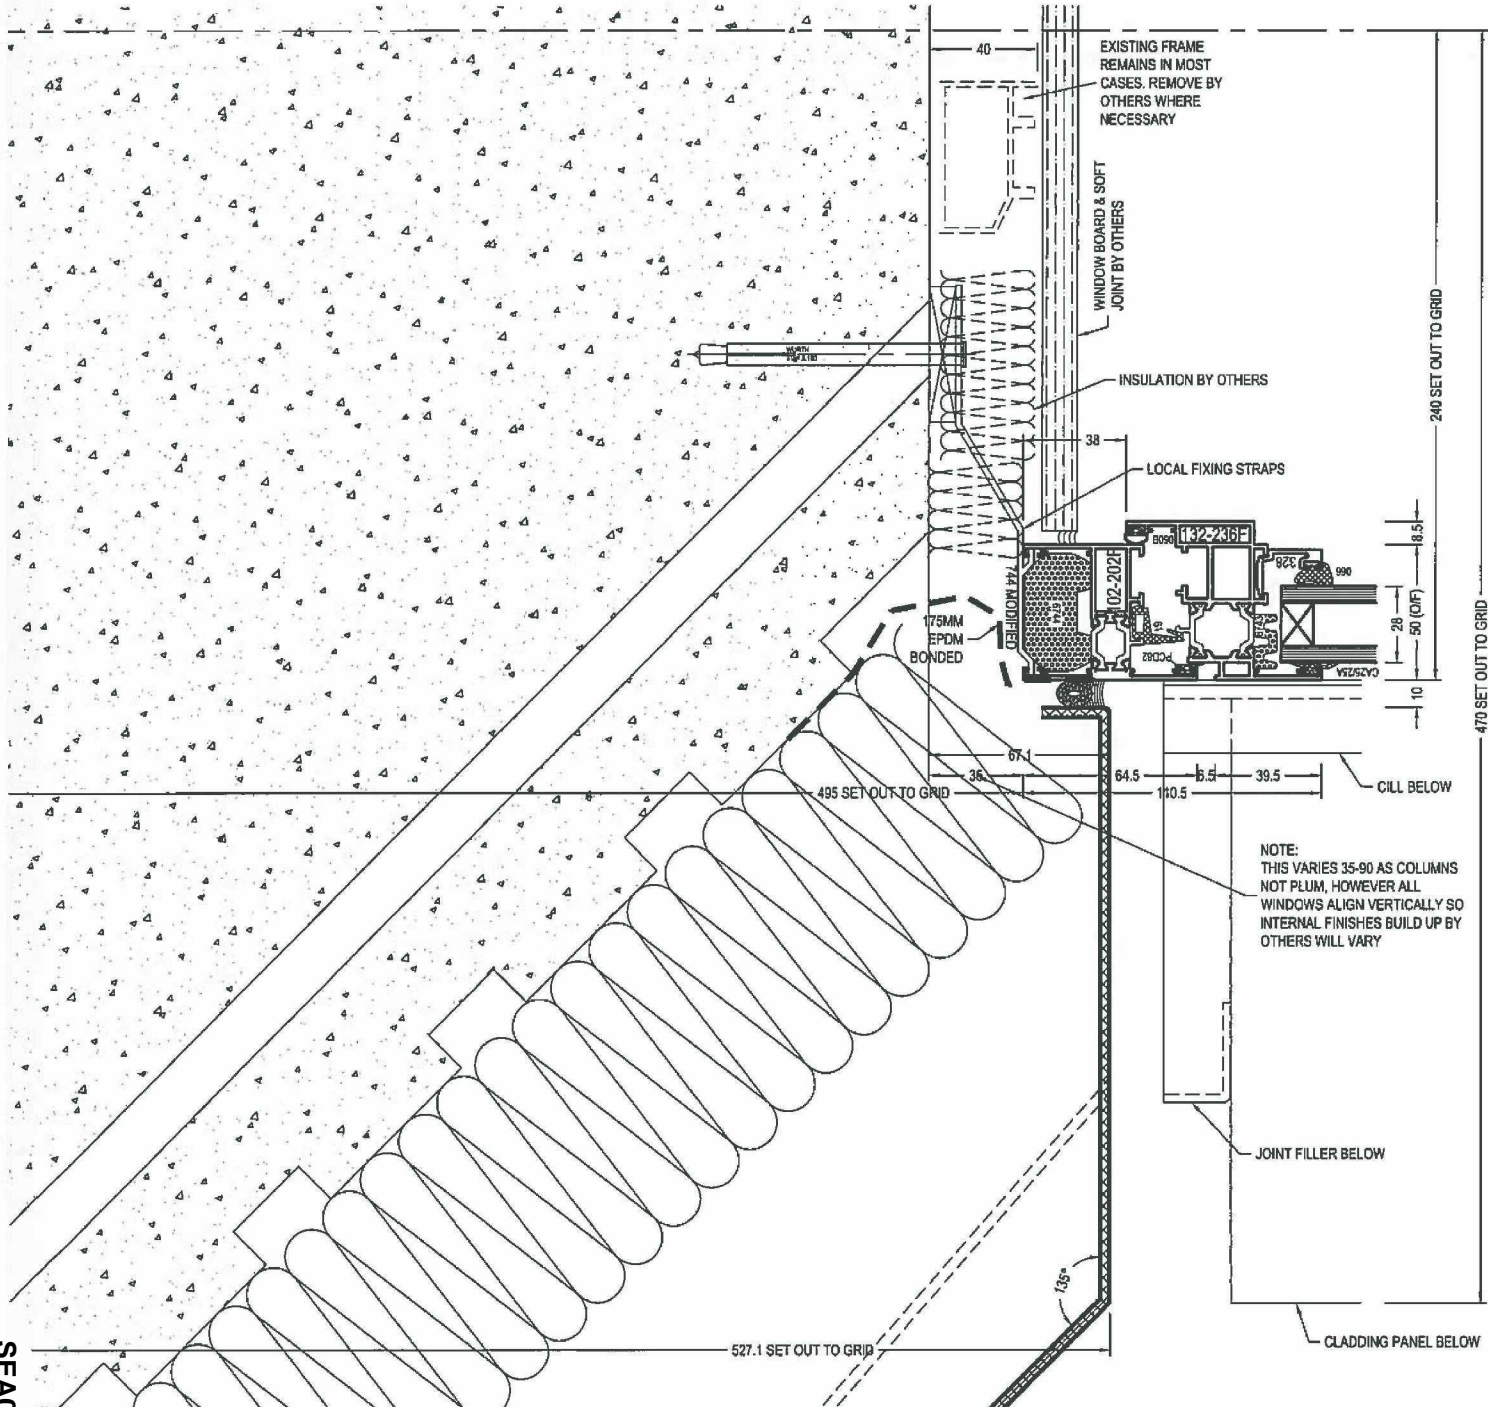

1
WINDOW JAMB
UPPER LEVELS

STUDIO E ARCHITECTS PALACE WHARF RAINVILLE ROAD LONDON W11 1LW		
15	Conforms to Design Intent	
16	Conforms to Design Intent subject to incorporation of comments. Revise and re-submit for category 'A' status	
17	Does not conform with Design Intent. Revise and re-submit	
<p>Drawing status is given for conformity with our Design Intent only and does not relieve the contractor/sub-contractor/trade contractor from responsibility for their design accuracy and completion.</p> <p>Comments made do not automatically constitute variation. Refer to separate specification clause for supplementary information regarding drawing status.</p>		
Date	Checked By Signature	Name (Print)
16/01/15		NSC
Date	Authorised Signature	Name (Print)

APPROVED FOR
CONSTRUCTION

SEA00003040/7

FILE 865.	D	13.01.15	CONSTRUCTION	Description	Project	Grenfell Tower Grenfell Rd, London, W11 1TQ	HARLEY HOUSE BROOKLANDS PARK FARNINGHAM ROAD CROWBOROUGH EAST SUSSEX TN6 2JD Tel: [REDACTED]	Drawing No: C1059-302	Rev: D	
	C	28.10.14	MIN JAMB GAP REDUCED							
	B	25.09.14	LOWER SPANDREL CLADDING ADDED							
	A	29.08.14	DIM ADDED, EPDM MOVED							
Rev	Date		Notes	SECTIONS	Drawn By:	bd KVL	Date:	20.08.14	Scale:	1:2@A3

STUDIO E ARCHITECTS
PALACE WHARF RAINVILLE ROAD LONDON W6 6RH

As Conforms to Design Intent


Conforms to Design Intent subject to incorporation of comments. Revise and re-submit for category 'A' status.

Does not conform with Design Intent. Revise and re-submit.


Notes
Drawing status is given for conformity with design intent only and does not relieve the contractor/sub-contractor/trade contractor from responsibility for their design accuracy and integration.

Comments made do not automatically constitute variation. Refer to separate specification clause for supplementary information regarding drawing status.


Date	Checked By Signature	Name (Print)
16/01/15		NSC
Date	Authorised Signature	Name (Print)

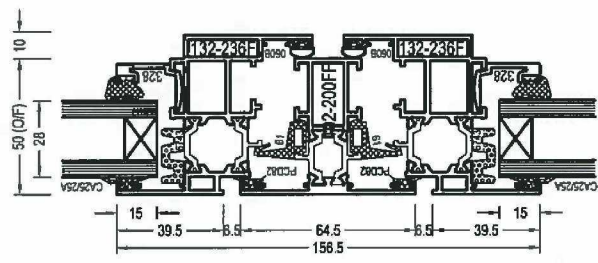

1
WINDOW MILLION
VENT / VENT

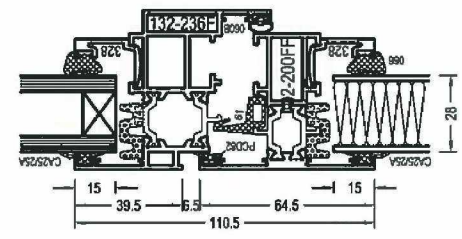

2
WINDOW MILLION
VENT / PANEL

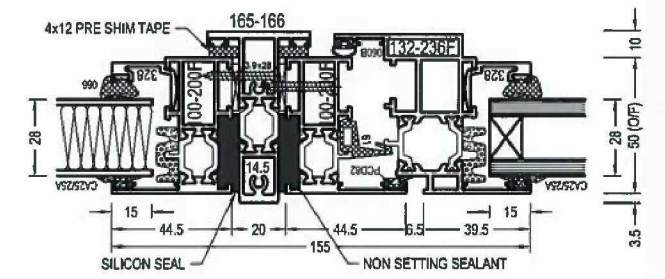


3
WINDOW COUPLING
PANEL / VENT

APPROVED FOR
CONSTRUCTION

FILE 855	Rev	Date	Notes	DESCRIPTION SECTIONS	PROJECT GRENFELL TOWER GRENFELL RD, LONDON, W11 1TQ	DRAWN BY bd KVL	DATE 20.08.14	SCALE 1:2@A3	HARLEY HOUSE BROOKLANDS PARK FARNINGHAM ROAD CROWBOURGH EAST SUSSEX TN6 2JD Tel:	Drawing No:	Rev:
	B	13.01.15	CONSTRUCTION							C1059-303	B
	A	29.08.14	DETAIL 3A ADDED								

①
WINDOW HEAD TRICKLE VENT
UPPER LEVELS

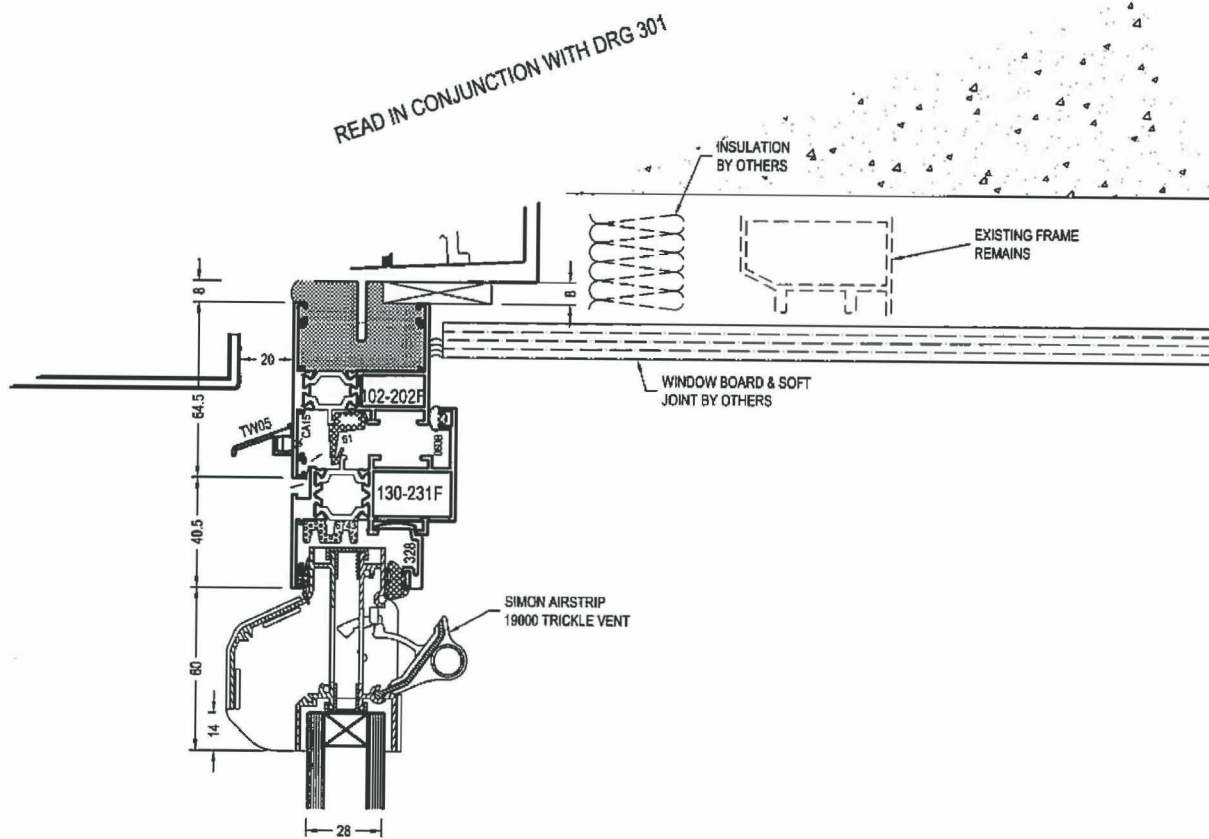


STUDIO E ARCHITECTS PALACE WHARF RAINVILLE ROAD LONDON W6 9HT		
A	Conforms to Design Intent	
	Conforms to Design Intent subject to incorporation of comments. Revise and re-submit for category 'A' status.	
	Does not conform with Design Intent. Revise and re-submit.	
<p>Design status is given for conformity with design intent only and does not relieve the contractor/trade contractor from responsibility for their design accuracy and execution.</p> <p>Comments made do not automatically constitute a separate specification document. Refer to separate specification documents for supplementary information regarding drawing status.</p>		
Date	Checked By Signature	Name (Print)
Date	Authorised Signature	Name (Print)


APPROVED FOR
CONSTRUCTION

FILE 855...	DESCRIPTION	SECTION	PROJECT	 HARLEY HOUSE BROOKLANDS PARK FARNINGHAM ROAD CROWBOROUGH EAST SUSSEX TN4 2JD Tel: [REDACTED]	Drawing No: C1059-307	Rev: B			
	REV	DATE	NOTES				DRAWN BY	DATE	SCALE
	-	-	-				bd KVL	22.09.14	1:20@A3

READ IN CONJUNCTION WITH DRG 301

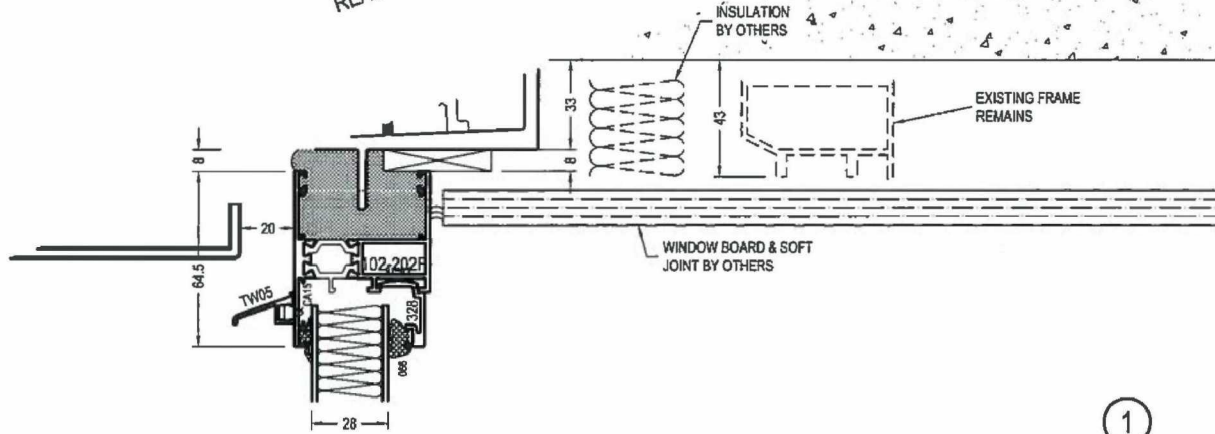

1
WINDOW HEAD LOUVRE
UPPER LEVELS

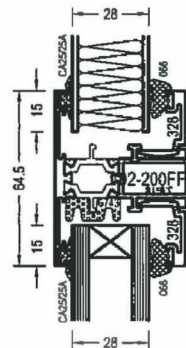


2
WINDOW LOUVRE TRANSOM
UPPER LEVELS


STUDIO E ARCHITECTS		
1 ALICE WHARF RAINVILLE ROAD LONDON W6 9HT		
A	Conforms to Design Intent	
	Conforms to Design Intent subject to incorporation of comments. Revise and re-submit for category 'A' status	
	Does not conform with Design Intent. Revise and re-submit.	
<p>Category 'A' status is given for conformity with outline intentions only and does not relieve the architect/sub-contractor/trade contractor from their liability for their design accuracy and performance.</p> <p>Comments made do not automatically constitute a revision. Refer to separate specification clause 1.1 for supplementary information regarding drawing status.</p>		
16/01/15	Checked By Signature	Name (Print) NSC
	Authorised Signature	Name (Print)

APPROVED FOR
CONSTRUCTION

FILE 855..	-	-	-	DESCRIPTION SECTIONS	PROJECT GRENFELL TOWER GRENFELL RD, LONDON. W11 1TQ	DRAWN BY bd KVL	DATE 22.09.14	SCALE 1:2@A3	HARLEY HOUSE BROOKLANDS PARK FARNINGHAM ROAD CROWBOROUGH EAST SUSSEX TN6 2JD Tel: [REDACTED]	DRAWING NO: C1059-308	REV: A
	A	14.01.15	CONSTRUCTION								
	Rev	Date	Notes								

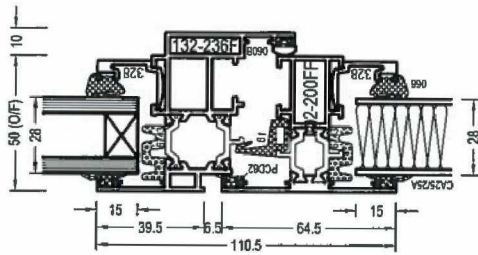

①
WINDOW MILLION
VENT / LOUVRE

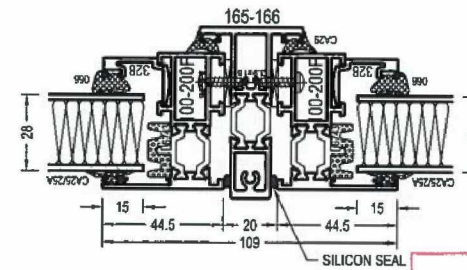

②
WINDOW COUPLING
LOUVRE / PANEL

STUDIO E ARCHITECTS
PALACE WHARF RAIRVILLE ROAD LONDON W6 9H

A Confirms to Design Intent.

Confirms to Design Intent subject to incorporation of comments. Revise and re-submit for category 'A' status.

Does not conform with Design Intent. Revise and re-submit.

No liability is given for conformity with outline drawing only and does not relieve the design-contractor/trade-contractor from their liability for their design accuracy and construction.

Any amendments made do not automatically constitute a revision. Refer to separate specification clause for further information regarding drawing.

Checked By Signature	Name (Print)
16/01/15	HSC
Authorised Signature	Name (Print)

**APPROVED FOR
CONSTRUCTION**

FILE 855..	-	-	-	Description: SECTIONS	Project: GRENFELL TOWER GRENFELL RD, LONDON. W11 1TQ	Drawn By: bd KVL	Date: 22.09.14	Scale: 1:2@A3	harley HARLEY HOUSE BROOKLANDS PARK FARNINGHAM ROAD CROWBOROUGH EAST SUSSEX TN6 2JD Tel: [REDACTED]	Drawing No: C1059-309	Rev: A
	A	14.01.15	CONSTRUCTION								
	Rev	Date	Notes								