



VENT POSITION
REVIEWED IN
MEETING 21/03
TO BE DOWN HERE

HARLEY ARCHITECTS	
100, 101, 102, 999, 1000.	

APPROVED FOR
CONSTRUCTION

FILE 855..	B 12.03.15 SURVEY HEIGHTS, TRANSOMS		ELEVATIONS	GRENELL TOWER GRENELL RD, LONDON. W11 1TQ	Drawn By: bd KVL	Date: 30.09.14	Scale: 1:30@A3	Rev: C1059-204	
	A 03.03.15 HANDING, FIREBREAKS, CONST.								
	Rev	Date							Notes



COMMENT AS
PREVIOUSLY REGARDING
LOCATION! → THIS CONFIGURATION
HAPPENS AT KITCHEN SIDE
B/C NOT A/D AS SHOWN.

STUDIO E ARCHITECTS
NOM 788
PLACE VILLE PARVILLE ROAD LONDON W8 9HH

REVISIONS

A	Initial Design Intent
B	Comments to Design Intent subject to incorporation of comments. Revised and resubmitted for authority 'A' status.
C	Does not comply with Design Intent. Revised and resubmitted.

NOTE
Drawing status is given for conformity with outline Design Intent only and does not constitute a contractual or prioritized connector from full responsibility to full design authority and integration.
Comments made on this drawing constitute a variation to the design. A variation clause for such changes is included in the drawing.
Date: 27.03.15 By: MSL (Print)

27.03.15 MSL


APPROVED FOR CONSTRUCTION

NOTE
VERTICAL FIREBREAKS NOT
REQD ON 4 COLUMNS, IE GRIDS 2
& 4 (NORTH & SOUTH)

END BAY - LEVEL WALKWAY +1 EAST & WEST ELEVATION
2 OFF LH BAY AS DRAWN (TYPES 2C+2D+3B)
2 OFF RH BAY OPP HAND (TYPES 3A+2E+2F)

FILE 855..	ELEVATIONS			Project: GRENELL TOWER GRENELL RD, LONDON. W11 1TQ			 HARLEY HOUSE BROOKLANDS PARK FARMINGHAM ROAD CROWBOROUGH EAST SUSSEX TN11 2JD Tel: [REDACTED]	Drawing No: C1059-205	Rev: B
	B	12.03.15	SURVEY HEIGHTS, TRANSOMS	Drawn By: bd  KVL	Date: 30.09.14	Scale: 1:30@A3			
	A	03.03.15	HANDING, FIREBREAKS, CONST.						
	Rev	Date	Notes						

SEA00003181/2

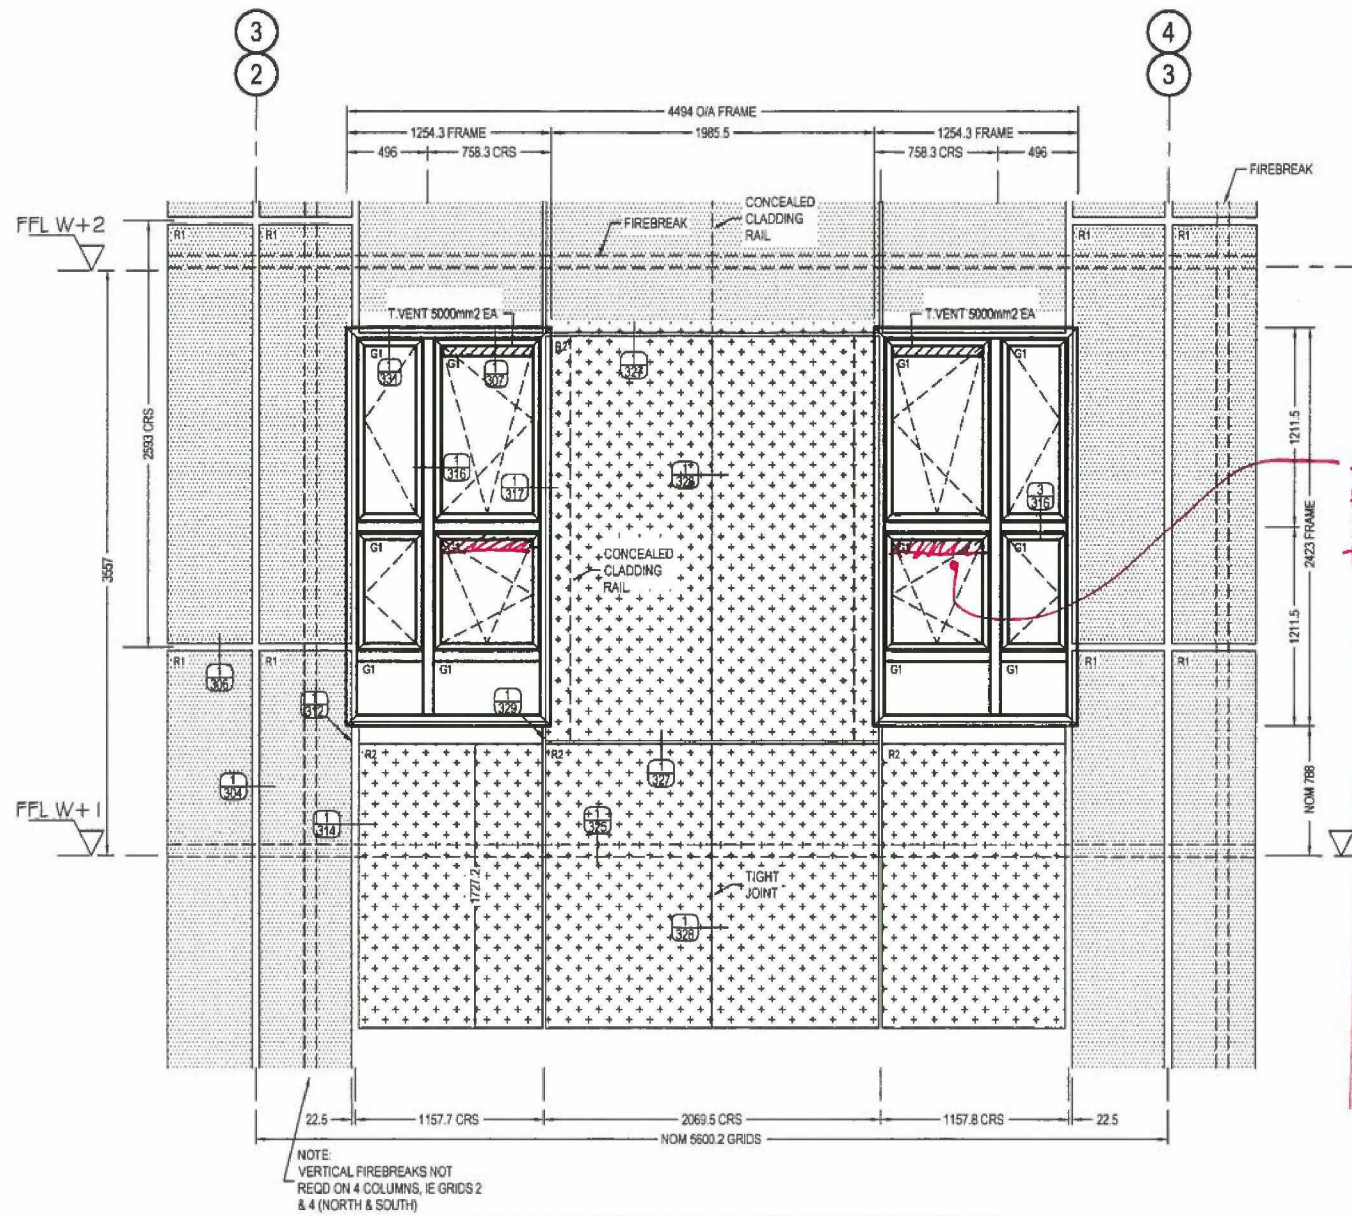

VENT POSITION
REVIEWED IN
MEETING 24/03
TO BE LOCATED HERE

STUDIO PROJECTS	
PALACE WHARF - RIVINGTON ROAD - JOHN	
A	Conceptual Design Intent
B	Conceptual Design Intent subject to inspection and comments by the client and relevant regulatory authorities
C	Design Intent subject to Design Intent Review and comments
Drawing status is given for conformity with outline Design Intent only and does not release the contractor from full responsibility for their design accuracy and integration.	
Contract documents do not automatically constitute a variation of the Design Intent unless a written instruction is issued for supplementary information regarding drawing status.	
Client	Name (Print)
Date	Date (Print)


ISSUED FOR APPROVAL

TYPICAL BAY - LEVEL WALKWAY +1 NORTH & SOUTH ELEVATION
8 OFF AS DRAWN (TYPES 2G+2H)

FILE 855...

-	-	-	Description: ELEVATIONS	Project: GRENELL TOWER GRENELL RD, LONDON. W11 1TQ	 HARLEY HOUSE BROOKLANDS PARK FARMINGHAM ROAD CROWBOROUGH EAST SUSSEX TN9 2JD Tel: [REDACTED]	Drawing No: C1059-206	Rev: A
-	-	-					
A	12.03.15	SURVEY HEIGHTS, TRANSOMS					
Rev	Date	Notes					

①
CLADDING JUNCTION
WALKWAY+1

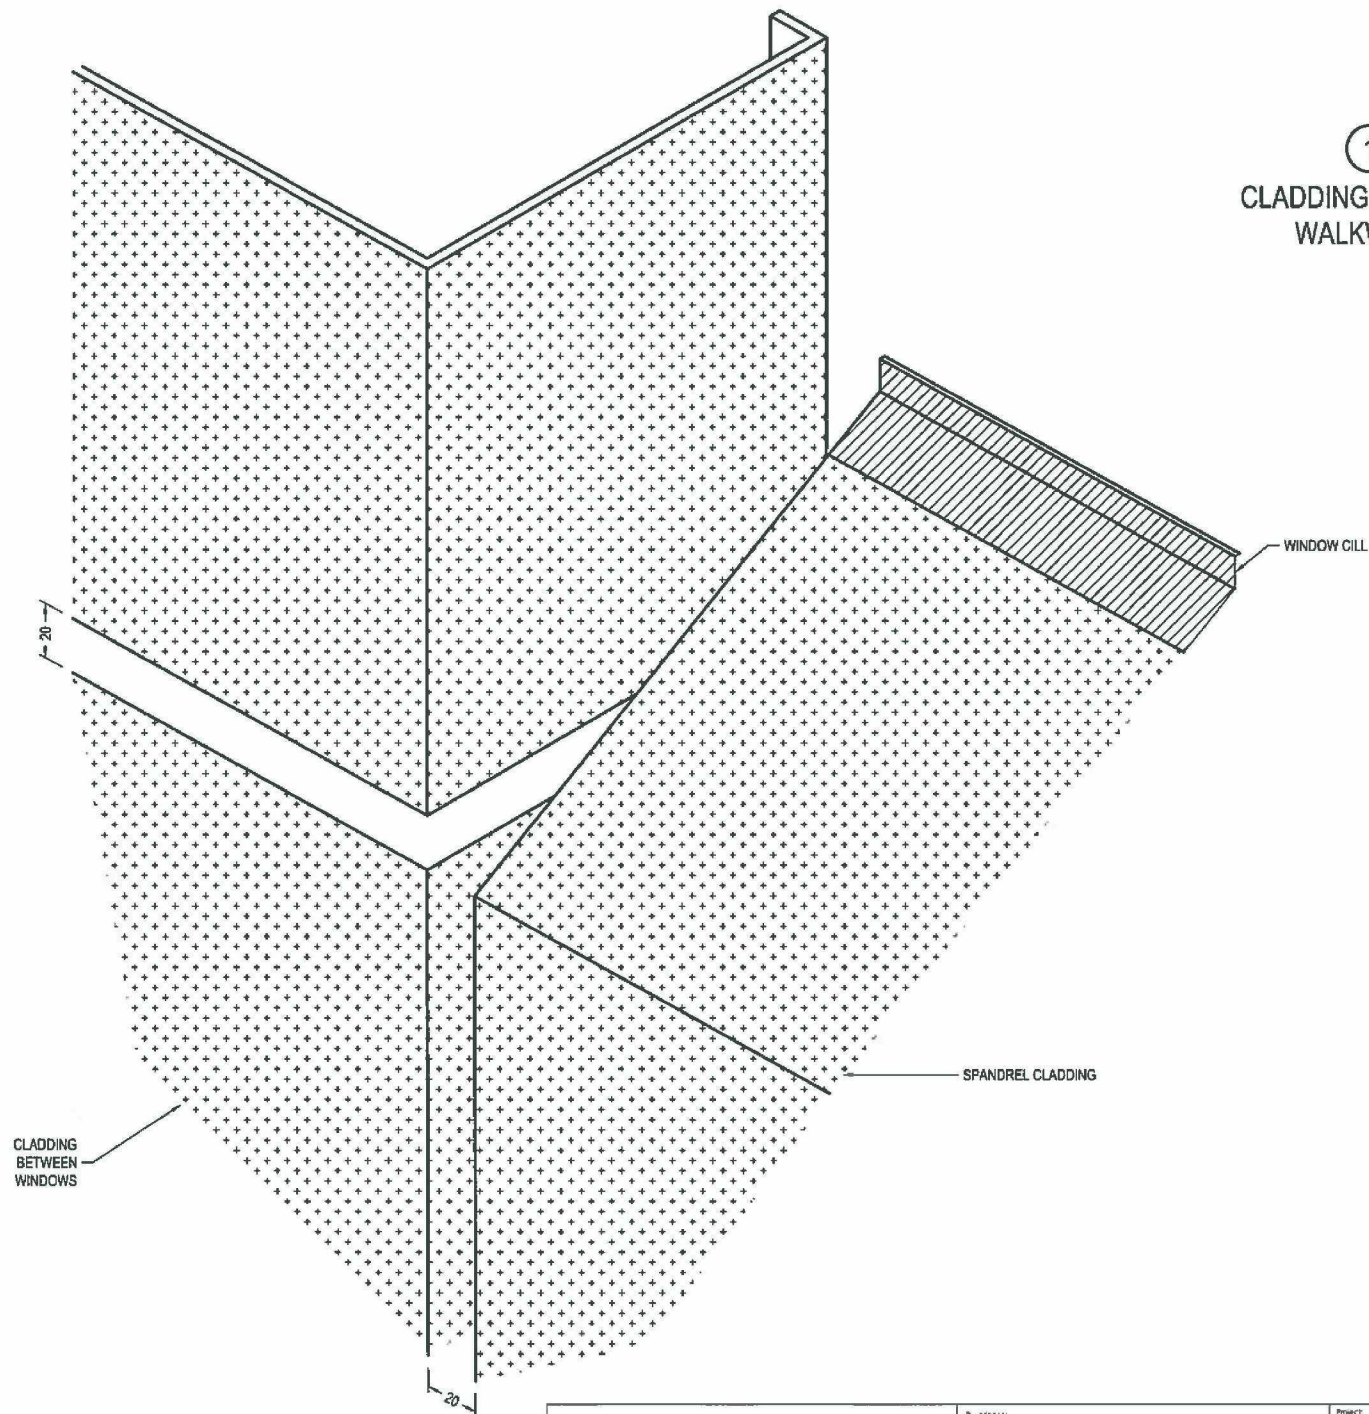

STUDIO E ARCHITECTS PALACE WHARF RAINVILLE ROAD LONDON W9 9HN		
(A)	Conforms to Design Intent	
B	Conforms to Design Intent subject to incorporation of comments. Revise and re-submit for category 'A' status	
C	Does not conform with Design Intent. Revise and re-submit	
Note: Drawing status is given for reference with outline Design Intent only. It does not relieve the contractor of his contractual responsibility for full responsibility for design accuracy and integrity. Comments are not automatically constitute a variation. It is the contractor's responsibility to provide supplementary information regarding drawing status.		
Date	Checked By Signature	Name (Print)
27/03/15	NSC	
Date	Authorised Signature	Name (Print)

ISSUED FOR
APPROVAL

FILE 855..

Rev	Date	Notes
-	-	-
-	-	-
-	-	-

DESCRIPTION:
SECTIONS

Project:
GRENfell TOWER
GRENfell RD, LONDON, W11 1TQ


Drawn By: bd KVL Date: 11.03.15 Scale: 1:3@A3

harley
HARLEY HOUSE
BROOKLANDS PARK
FARNINGHAM ROAD
CROWBOROUGH
EAST SUSSEX
TN6 2JD
Tel: [REDACTED]

Drawing No: C1059-329 Rev: -

SEA00003181_0004

SEA00003181/4

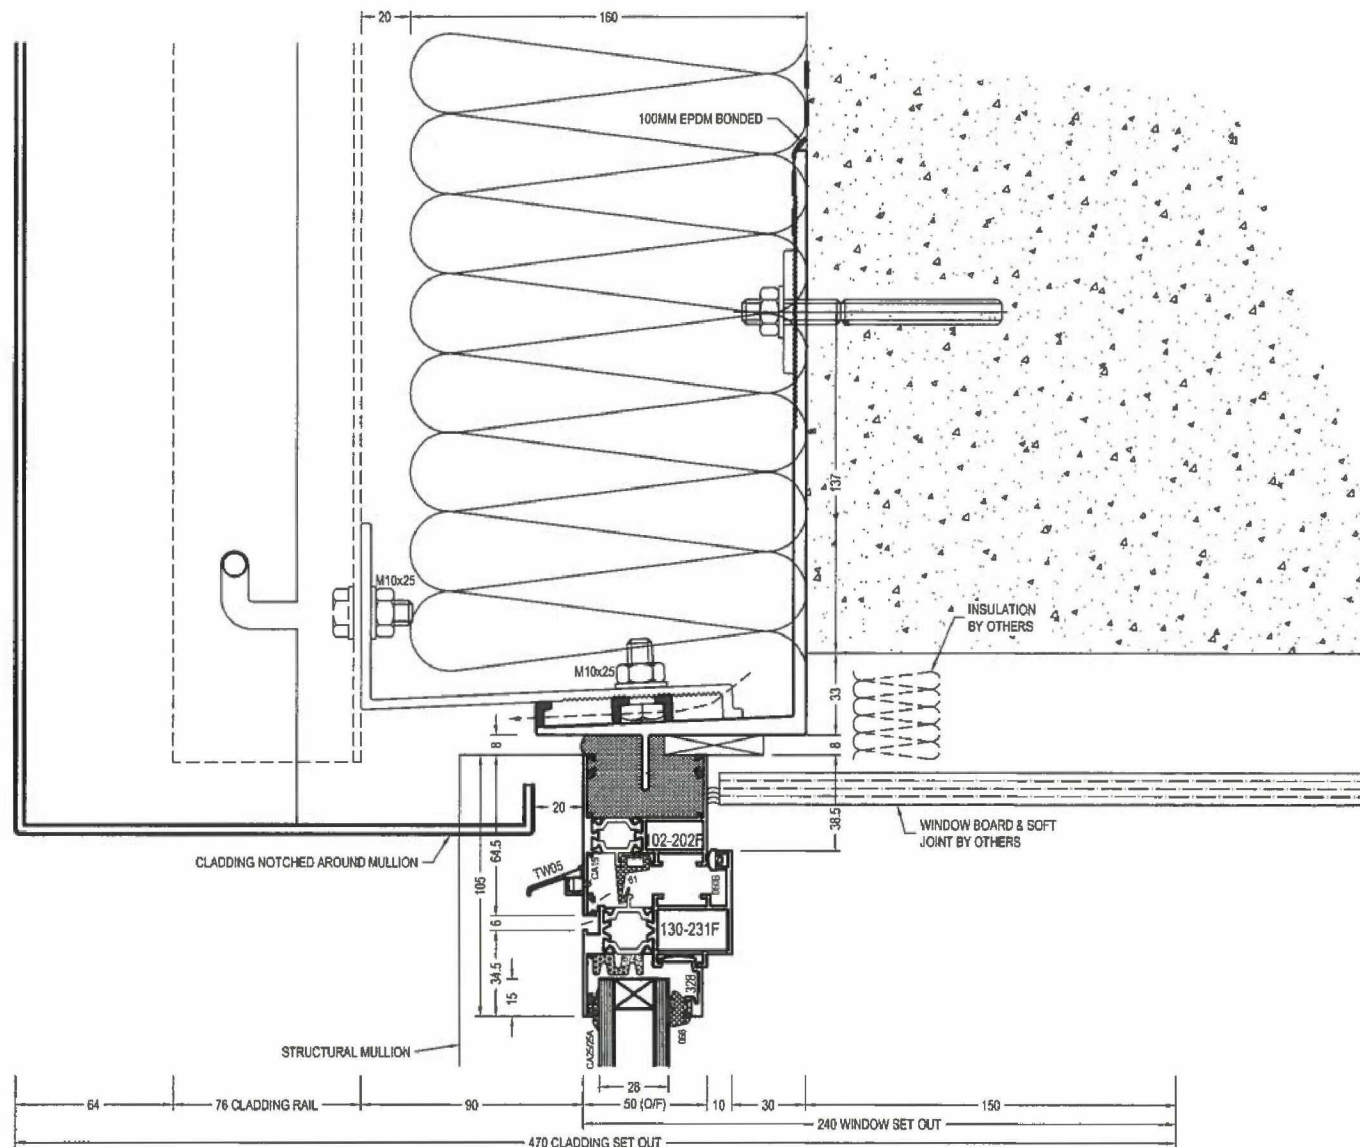

STUDIO 10 ARCHITECTS		
PALACE WHARF (RAINVILL) ROAD, WINDSOR, WINDSOR, WINDSOR		
A	Conforms to Design Intent	
B	Conforms to Design Intent subject to incorporation of comments, revise and resubmit for category A status	
C	Does not conform with Design Intent. Revise and resubmit	

Drawing status is given for conformity with outline Design Intent only and does not relieve the contractor from full responsibility for their design accuracy and integration.

Comments, notes do not automatically constitute a variation. Refer to relevant specification clause for supplier for information regarding drawing status.

Date	Reviewed by	Name (Print)

Date	Approved by	Name (Print)

ISSUED FOR APPROVAL


FILE 855..

Rev	Date	Notes
-	-	-
-	-	-
-	-	-
-	-	-

Sections

Grenfell Tower		
Grenfell Rd, London, W11 1TQ		
Drawn By: bd KVL	Date: 11.03.15	Scale: 1:3@A3

harley	
HARLEY HOUSE BROOKLANDS PARK FARNINGHAM ROAD CROWBOROUGH EAST SUSSEX TN6 2JD	
Drawing No: C1059-331	Rev: -

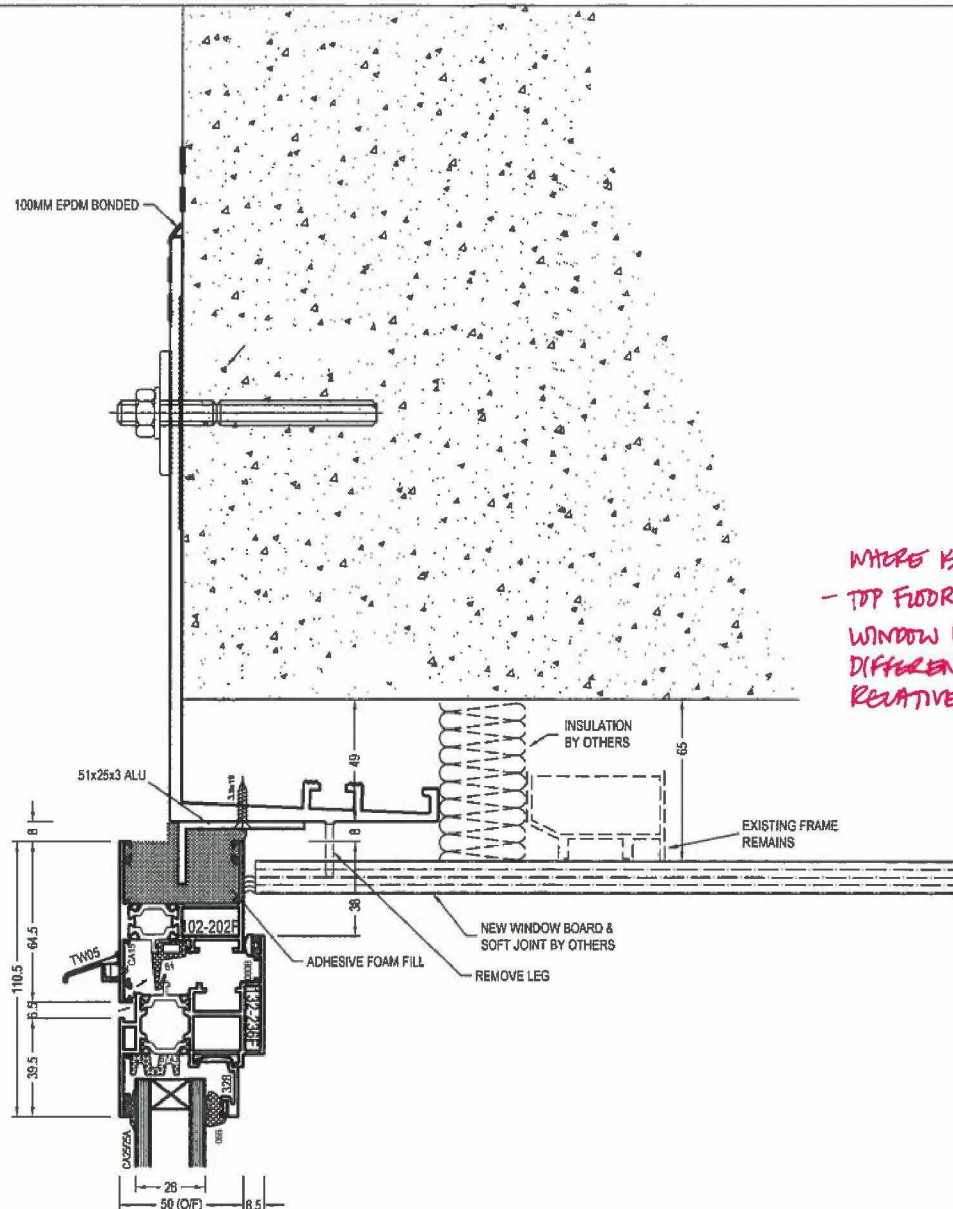

1
WINDOW HEAD
W+20

WHERE IS THIS WINDOW?
- TOP FLOOR (?)
WINDOW HEAD IN
DIFFERENT POSITION
RELATIVE TO SLAB (?)

STUDIO 100	
PALACE WHARF, 100, 101, 102, 999, 1000	

ISSUED FOR
APPROVAL

FILE 865..		SECTIONS		Project: GRENELL TOWER GRENELL RD, LONDON. W11 1TQ		harley HARLEY HOUSE BROOKLANDS PARK FARMINGHAM ROAD CROWBOROUGH EAST SUSSEX TN6 3JD	
Rev	Date	Notes		Drawn By: bd KVL	Date: 11.03.15	Scale: 1:30/A3	Drawing No: C1059-330