

AUDIO E ARCHITECTS 10 FRAINVILLE ROAD LONDON W6 9HN		
Date	Prepared By	Name (Print)
03/06/15 NSL	NSL	NEIL CANNON
Date	Checked By	Name (Print)

**APPROVED FOR CONSTRUCTION**

SEA00003240/1


FILE 855..

Rev	Date	Notes
-	-	-
-	-	-
-	-	-

Description:	
ELEVATIONS	
Project:	
GRENELL TOWER GRENELL RD, LONDON, W11 1TG	
Drawn By:	Date:
bd KVL	30.09.14
Scale:	
1:30@A3	

Project:	
GRENELL TOWER GRENELL RD, LONDON, W11 1TG	
Drawn By:	Date:
bd KVL	30.09.14
Scale:	
1:30@A3	

<b>harley</b>	
HARLEY HOUSE BROOKLANDS PARK FARNINGHAM ROAD CROWBOROUGH EAST SUSSEX TN6 2JD Tel: [REDACTED]	
Drawing No:	Rev:
C1059-216	-

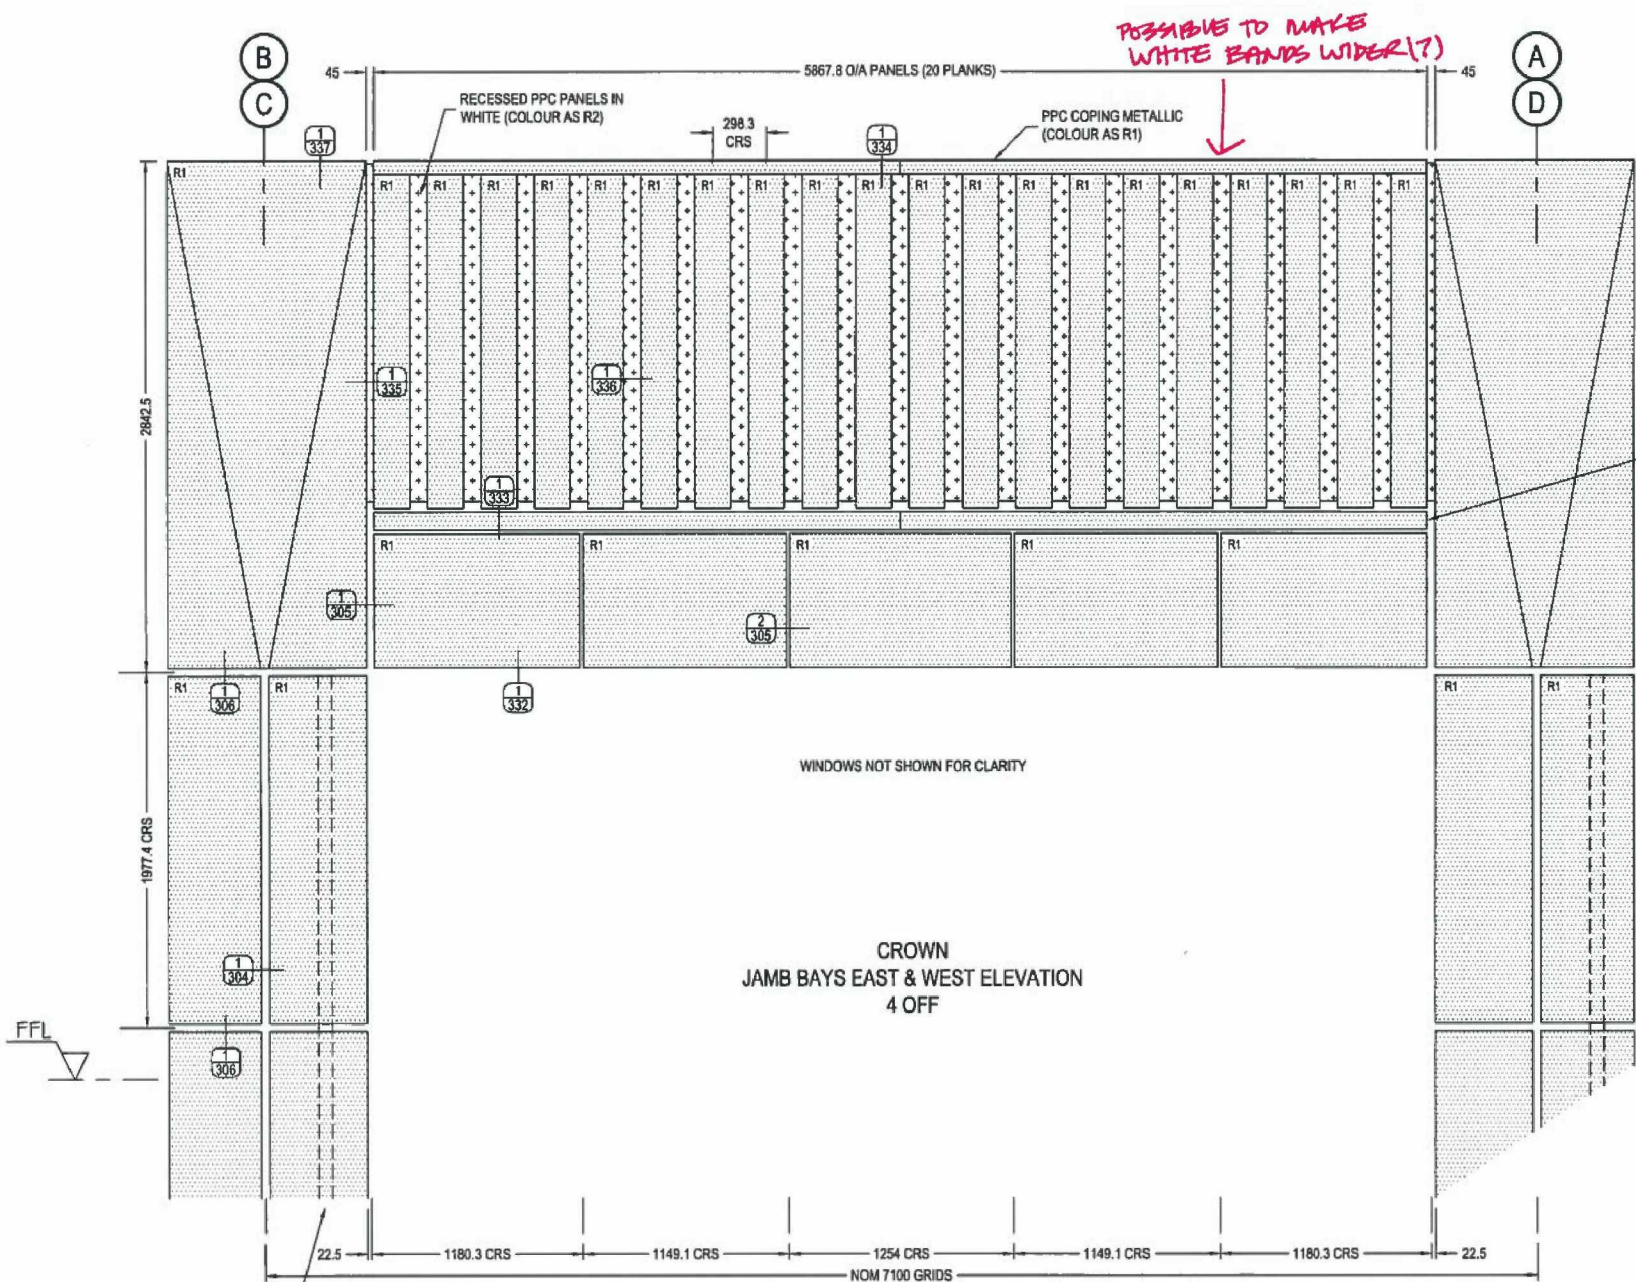

STUDIO E ARCHITECTS PALACE WHARF SAFFRAINE ROAD LONDON W8 5SN		
A	Confirms to Design Intent	
<b>B</b>	Confirms to Design Intent subject to incorporation of comments. Revise and re-submit for approval status	
C	Draw not conform with Design Intent. Revise and re-submit	
<p>Note Drawing status is given for conformity with outline Design Intent only. It does not relieve the contractor/sub-contractor from full responsibility for design accuracy and integration. Comments made do not automatically constitute a variation. Refer to separate specification clause for supplementary information regarding drawing status.</p>		
Date	Checked By Signature	Name (Print)
03/06/15	NBL	NBL CLARKE
Date	Authorised Signature	Name (Print)

**APPROVED FOR CONSTRUCTION**


NOTE:  
VERTICAL FIREBREAKS NOT REQD ON 4 COLUMNS, IE GRIDS 2 & 4 (NORTH & SOUTH)

Rev	Date	Notes
-	-	-
-	-	-
-	-	-

FILE 855..	Description: <b>ELEVATIONS</b>
------------	-----------------------------------

Project: <b>GRENFELL TOWER GRENFELL RD, LONDON. W11 1TQ</b>
Drawn By: <b>bd KVL</b>
Date: <b>30.09.14</b>
Scale: <b>1:30@A3</b>

<b>harley</b> HARLEY HOUSE BROOKLANDS PARK FARNINGHAM ROAD CROWBOROUGH EAST SUSSEX TN6 2JD Tel: [REDACTED]	Drawing No: <b>C1059-217</b>	Rev: -
---	---------------------------------	-----------

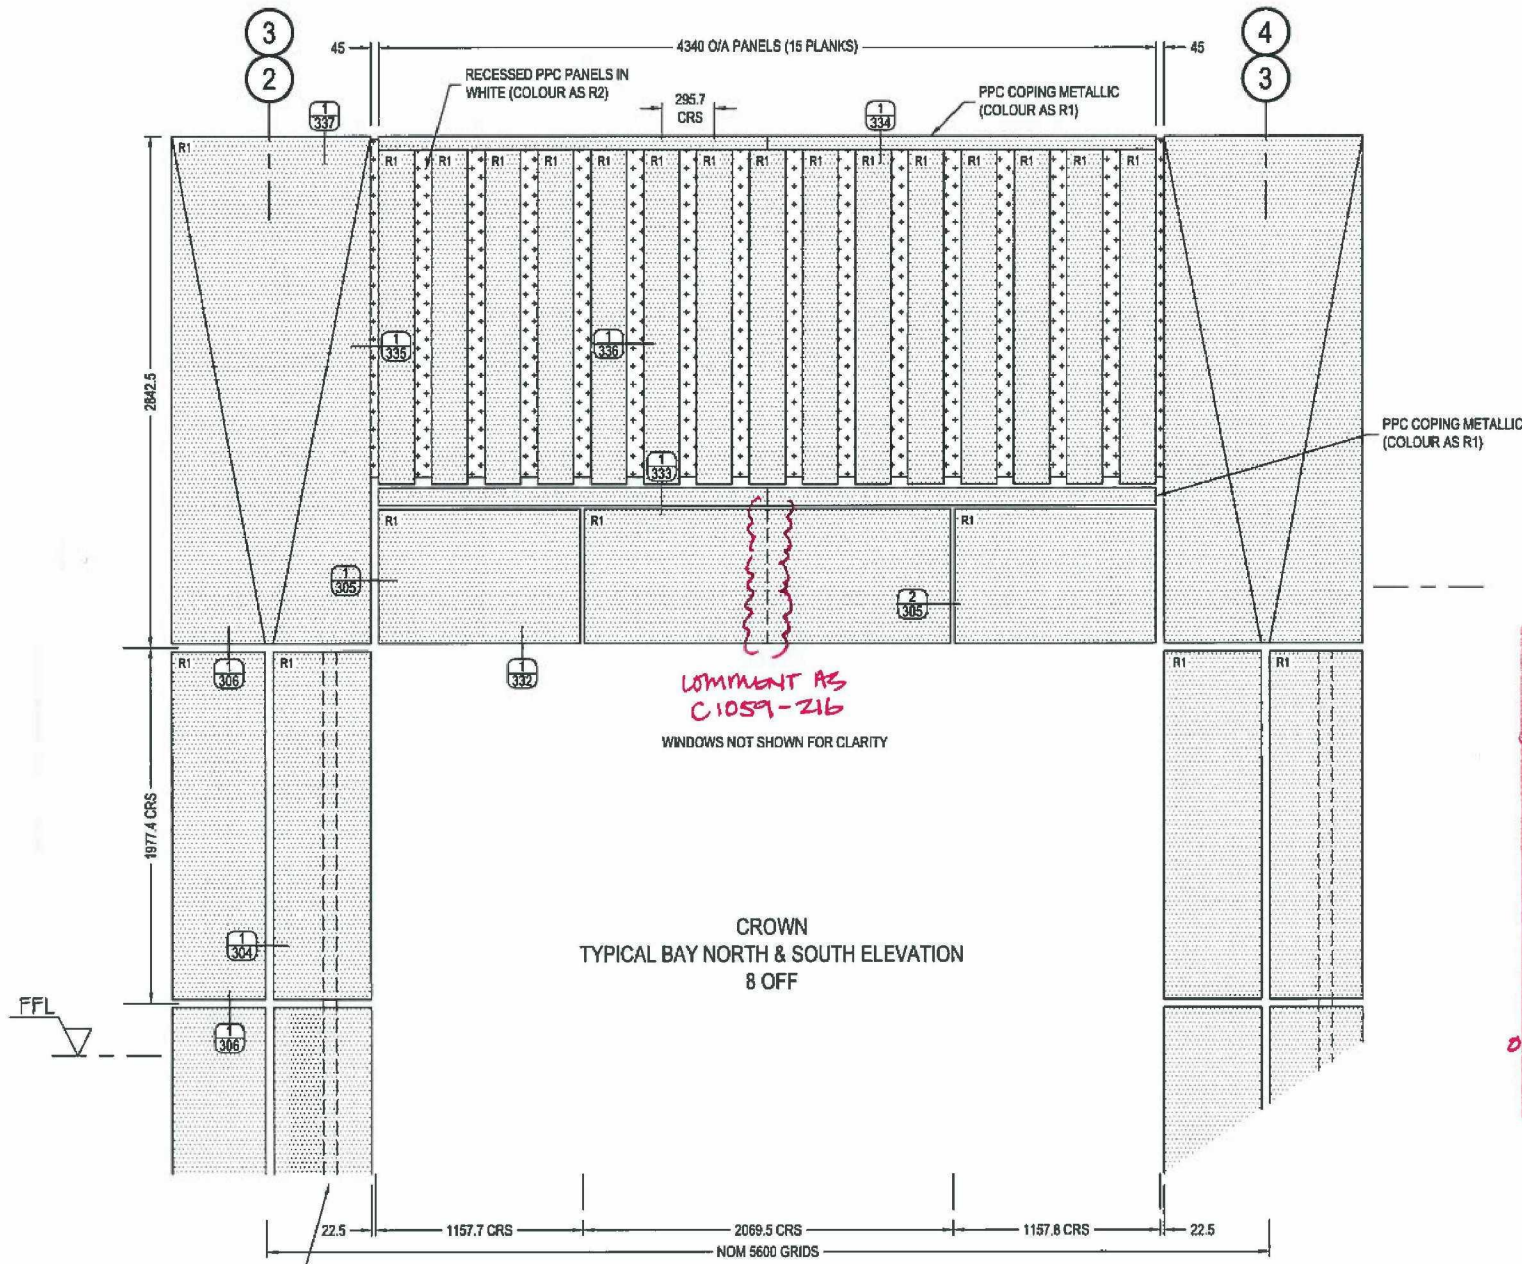

COMMENT AS  
C1059-216  
WINDOWS NOT SHOWN FOR CLARITY

CROWN  
TYPICAL BAY NORTH & SOUTH ELEVATION  
8 OFF

PPC COPING METALLIC  
(COLOUR AS R1)

STUDIO E ARCHITECTS  
PALACE WHARF RAMVILLE ROAD LONDON W8 9HN

A	Confirms to Design Intent
<b>B</b>	Confirms to Design Intent subject to incorporation of comments. Revise and re-submit to category 'A' status
C	Does not conform with Design Intent. Revise and re-submit

Note:  
Drawing status is given for conformity with outline Design Intent only and does not relieve the contractor/sub-contractor/trade contractor from full responsibility for their design accuracy and integration.  
Comments made do not automatically constitute a variation. Refer to separate specification clause for supplementary information regarding drawing status.

Date	Checked By	Name (Print)
03/06/15	NSC	NEAL CRAWFORD
Date	Approved	Name (Print)

APPROVED FOR  
CONSTRUCTION


FILE 855..

Rev	Date	Notes
-	-	-
-	-	-
-	-	-

Description	ELEVATIONS
Project	GRENFELL TOWER GRENFELL RD, LONDON. W11 1TQ
Drawn By	bd KVL
Date	30.09.14
Scale	1:30@A3

Project	GRENFELL TOWER GRENFELL RD, LONDON. W11 1TQ
Drawn By	bd KVL
Date	30.09.14
Scale	1:30@A3

Project	GRENFELL TOWER GRENFELL RD, LONDON. W11 1TQ
Drawn By	bd KVL
Date	30.09.14
Scale	1:30@A3
Client	HARLEY HOUSE BROOKLANDS PARK FARNINGHAM ROAD CROWBOROUGH EAST SUSSEX TN6 2JD Tel: [REDACTED]
Drawing No.	C1059-216
Rev.	

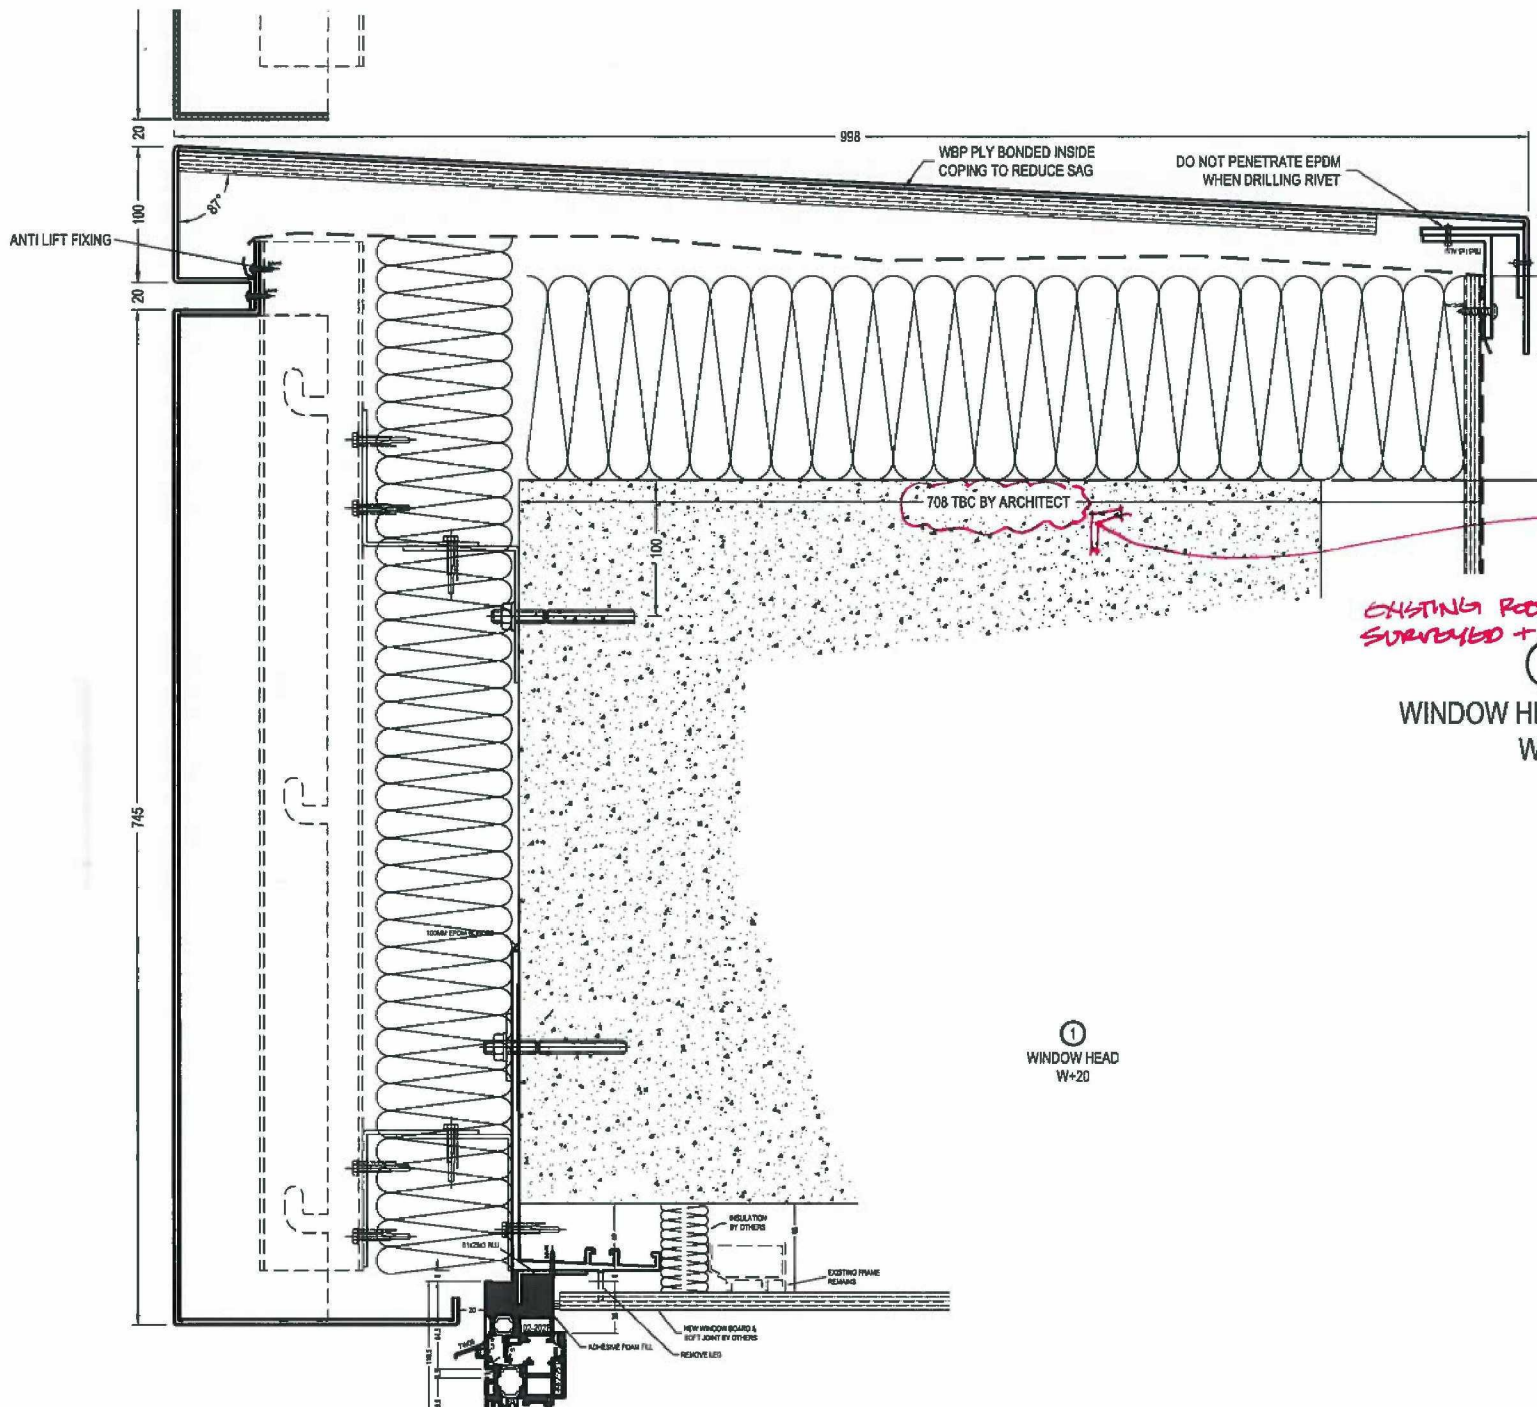


EXISTING ROOF PARAPET REQUIRES TO BE SURVEYED + METAL COPINGS / FLASHINGS TO FIT OVER. ①

WINDOW HEAD / COPING  
W+20

STUDIO E ARCHITECTS PALACE WHARF RAINVILLE ROAD LONDON W6 9HN		
A	Conforms to Design Intent	
<b>B</b>	Conforms to Design Intent subject to incorporation of comments. Revise and re-submit for category A status.	
C	Does not conform with Design Intent. Revise and re-submit	
<p>Note: Drawing status is given for conformity with outline Design Intent only and does not relieve the contractor/sub-contractor/trade contractor from full responsibility for their design accuracy and integration Comments made do not automatically constitute a variation. Refer to contract specification clause for supplementary information regarding drawing status</p>		
Date	Checked By	Name (Print)
03/06/15	NSC	NEIL CRAWFORD
Date	Author/Signatures	Name (Print)

ISSUED FOR APPROVAL


FILE 855. <table border="1"> <thead> <tr> <th>Rev</th> <th>Date</th> <th>Notes</th> </tr> </thead> <tbody> <tr> <td>-</td> <td>-</td> <td>-</td> </tr> <tr> <td>-</td> <td>-</td> <td>-</td> </tr> </tbody> </table>	Rev	Date	Notes	-	-	-	-	-	-	Description: <b>SECTIONS</b>	Project: <b>GRENFELL TOWER GRENFELL RD, LONDON, W11 1TQ</b>	HARLEY HOUSE BROOKLANDS PARK FARNINGHAM ROAD CROWBOROUGH EAST SUSSEX TN4 2JD Tel: [REDACTED]	Drawing No: C1059-332	Rev: -
	Rev	Date	Notes											
-	-	-												
-	-	-												
Drawn By: bd KVL	Date: 11.03.15	Scale: 1:4@A3	Drawing No: C1059-332	Rev: -										

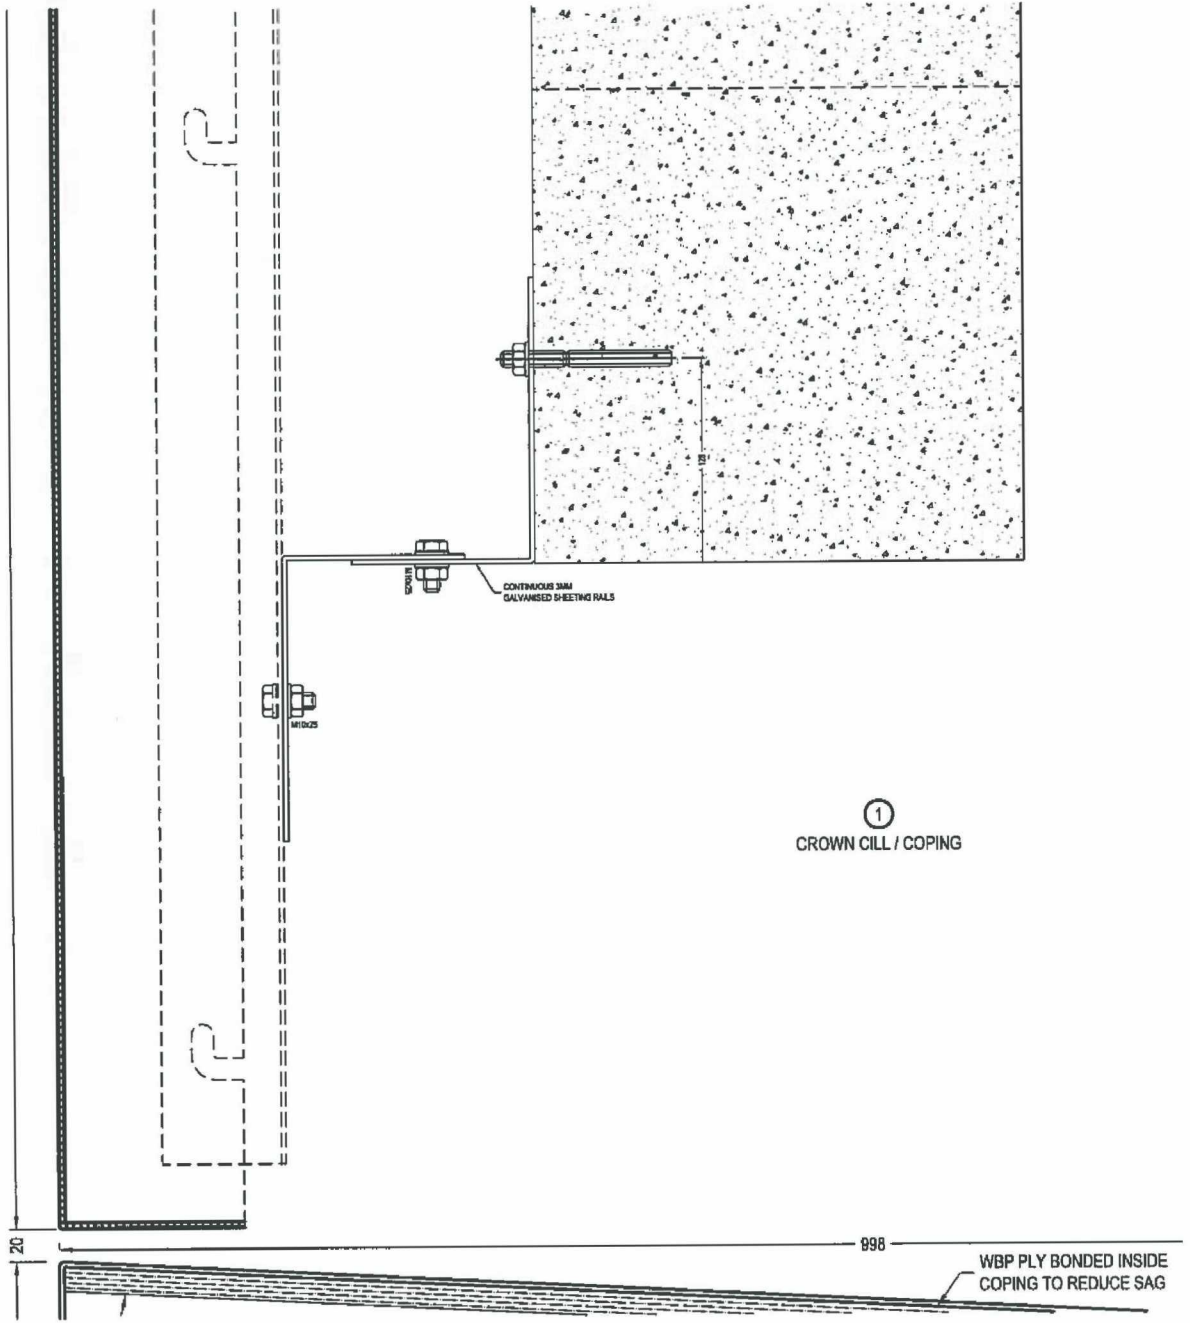

STUDIO E ARCHITECTS PALACE WHARF RAINVILLE ROAD LONDON W5 9HN		
A	Conforms to Design Intent	
B	Conforms to Design Intent subject to incorporation of comments. Revise and re-submit for category A status	
C	Does not conform with Design Intent. Revise and re-submit	
<p>Note Drawing status is given for conformity with outline Design Intent only and does not relieve the contractor/sub-contractor/trade contractor from full responsibility for their design accuracy and integration. Comments made do not automatically constitute a variation. Refer to separate specification clause for supplementary information regarding drawing status.</p>		
Date	Checked By Signature	Name (Print)
03/06/15	NEC	NEC CRAWFORD
Date	Approved Signature	Name (Print)

ISSUED FOR APPROVAL

FILE 865..	-	-	-
	-	-	-
	Rev	Date	Notes
DESCRIPTION: SECTIONS			
Project:		Project:	
Grenfell Tower		Grenfell Tower	
Grenfell Rd, London, W11 1TQ		Grenfell Rd, London, W11 1TQ	
Drawn By:	Date:	Scale:	
bd KVL	11.03.15	1:4@A3	
<p>HARLEY HOUSE BROOKLANDS PARK FARNINGHAM ROAD CROWBOROUGH EAST SUSSEX TN6 2JD Tel: [REDACTED]</p>		Drawing No:	Rev:
		C1059-333	-

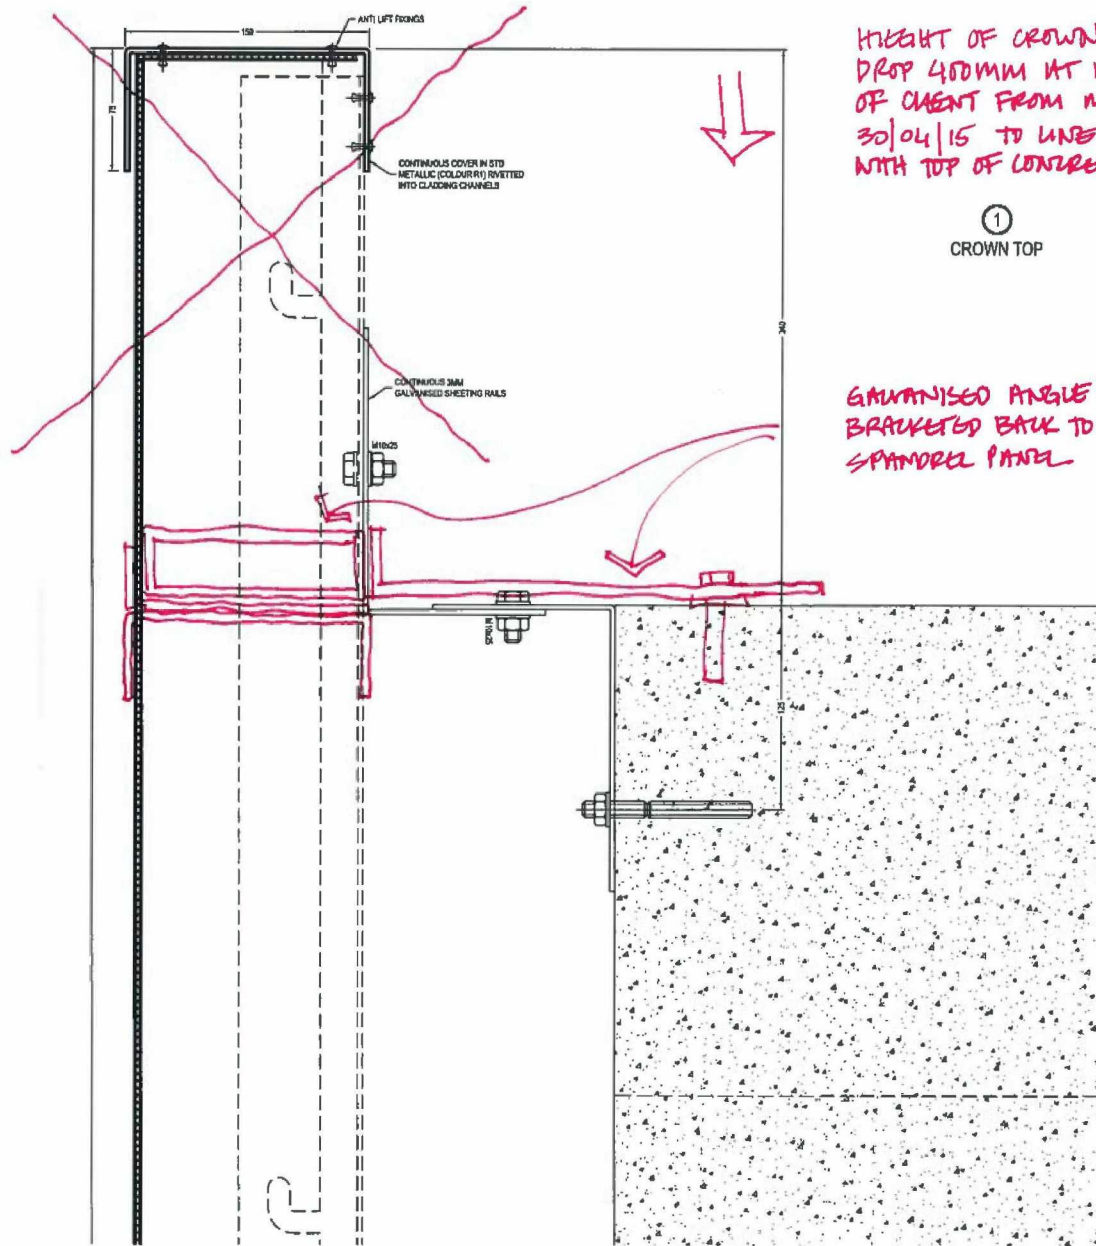

HEIGHT OF CROWN TO DROP 400MM AT REQUEST OF CLIENT FROM MEETING 30/04/15 TO LINE THROUGH WITH TOP OF CONCRETE SPANDREL.

①  
CROWN TOP

GALVANISED ANGLE OR RHS BRACKETED BACK TO CONCRETE SPANDREL PANEL

STEIN E ARCHITECTS FALACE WHARF RAINVILLE ROAD LONDON W6 9HN		
A	Confirms to Design Intent	
<b>B</b>	Confirms to Design intent subject to incorporation of comments. Revise and resubmit for category A status.	
C	Does not conform with Design Intent. Revise and re-submit	
<p>Note Drawing status is given for conformity with outline Design Intent only and does not relieve the contractor/sub-contractor/trade contractor from full responsibility for their design accuracy and integration. Comments made do not automatically constitute a variation. Refer to contract specification clause for supplementary information regarding drawing status.</p>		
Date	Checked By Signature	Name (Print)
03/06/15	NSC	NEIL CRAWFORD
Date	Authorised Signature	Name (Print)

ISSUED FOR APPROVAL

FILE 855...

Rev	Date	Notes
-	-	-
-	-	-
-	-	-


DESCRIPTION: SECTIONS

Project: GRENFELL TOWER  
GRENFELL RD, LONDON, W11 1TQ

Drawn By: bd KVL Date: 11.03.15 Scale: 1:3@A3

**harley**  
HARLEY HOUSE  
BROOKLANDS PARK  
FARNINGHAM ROAD  
CROWBOROUGH  
EAST SUSSEX  
TN6 2JD  
Tel: [REDACTED]

Drawing No: C1059-334 Rev: -

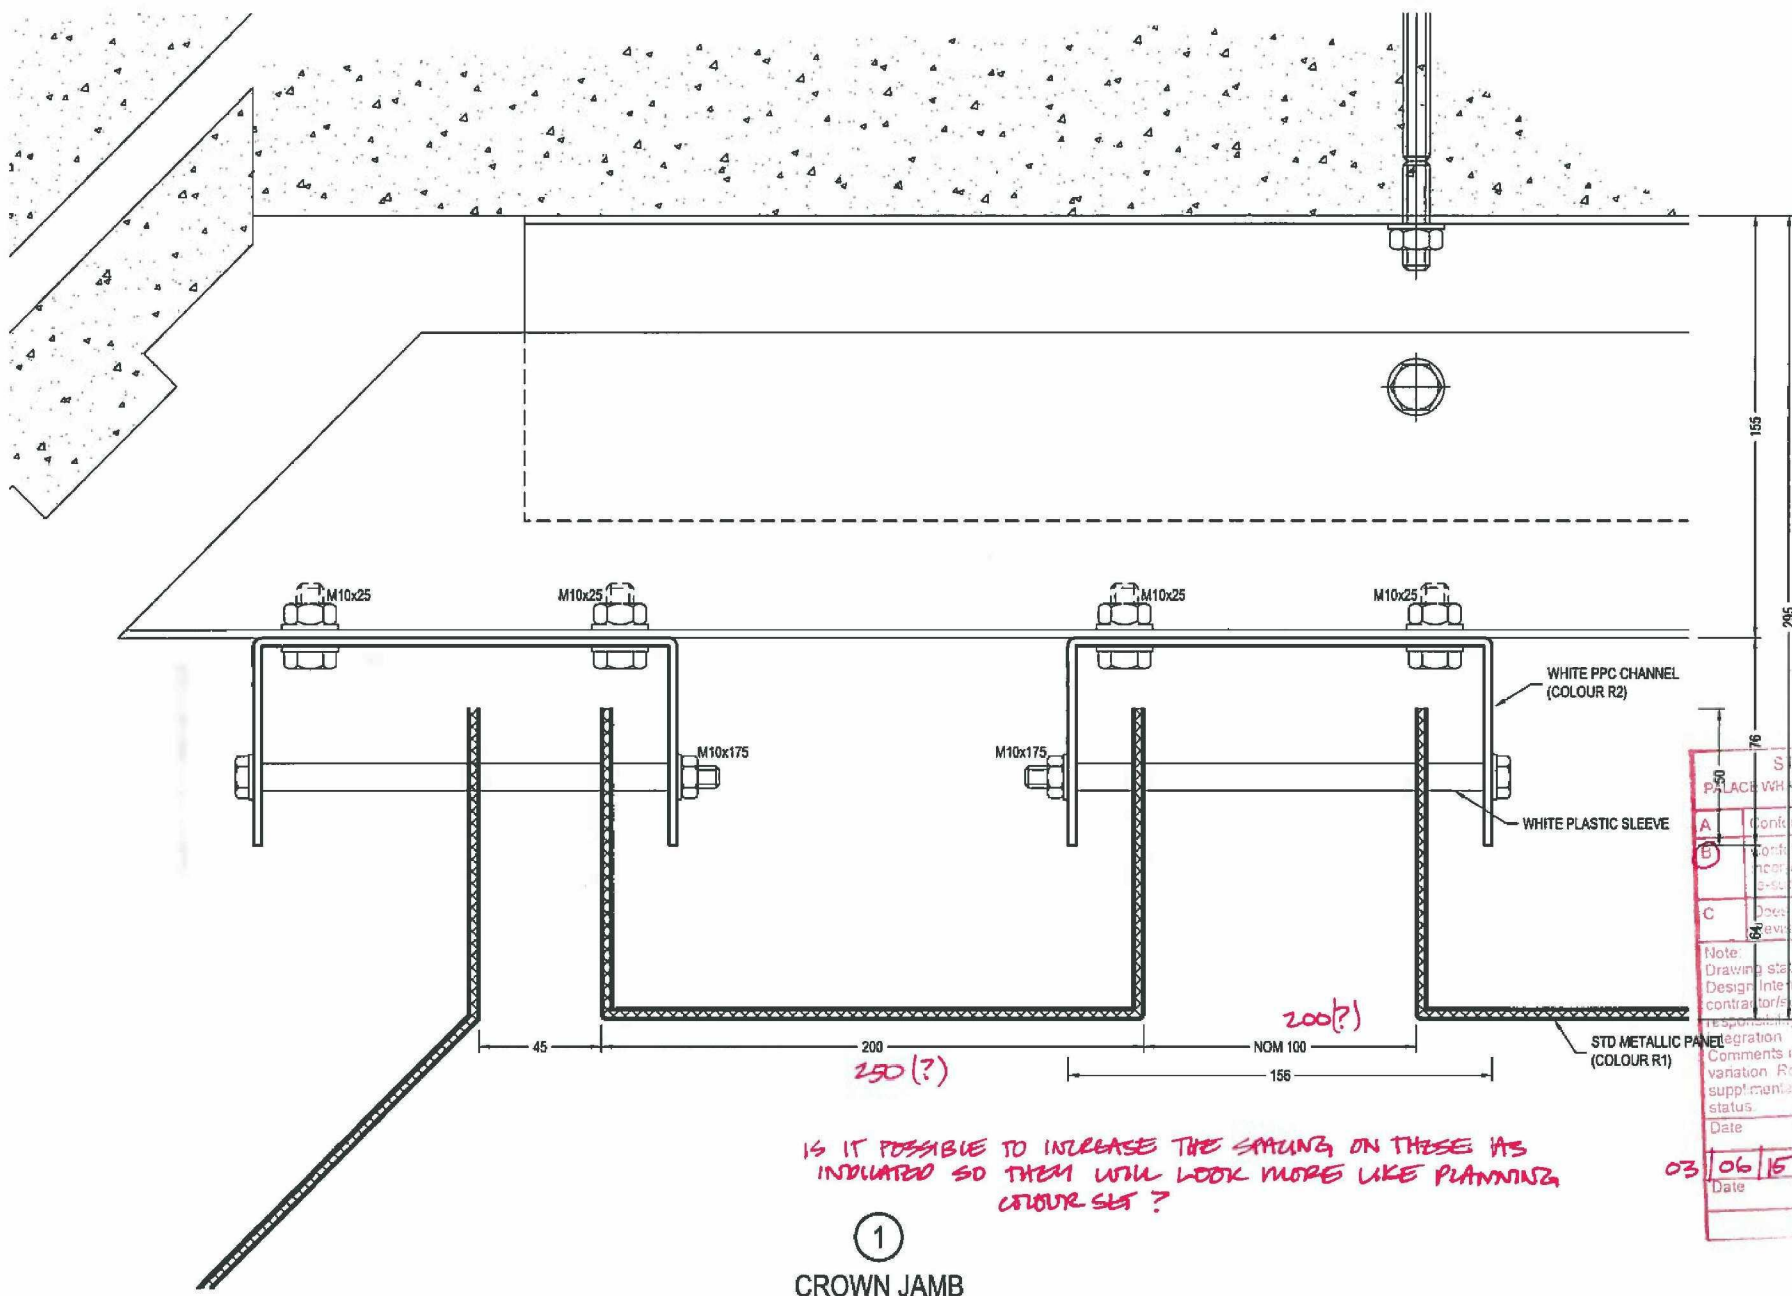

①  
CROWN JAMB

IS IT POSSIBLE TO INCREASE THE SPACING ON THESE M10x175 BOLTS INDICATED SO THEY WILL LOOK MORE LIKE PLANNING COLOUR SET ?

STUDIO E ARCHITECTS  
PALACE WHARF RAHVILLE ROAD LONDON W6 9HN

A	Confirms to Design Intent
B	Confirms to Design Intent subject to incorporation of comments. Revise and re-submit for category A status
C	Does not conform with Design Intent. Revise and re-submit

Note:  
Drawing status is given for conformity with outline Design Intent only and does not relieve the contractor/sub-contractor/trade contractor from full responsibility for their design accuracy and integration  
Comments made do not automatically constitute a variation. Refer to separate specification clause for supplementary information regarding drawing status

Date	Checked by Signature	Name (Print)
03/06/15	NEC	NEC GRANFORD
Date	Approved Signature	Name (Print)

ISSUED FOR APPROVAL


FILE 855..

Rev	Date	Notes
-	-	-
-	-	-
-	-	-

DESCRIPTION	SECTIONS
-------------	----------

PROJECT	GRENFELL TOWER GRENFELL RD, LONDON, W11 1TQ
DRAWN BY	bd KVL
DATE	11.03.15
SCALE	1:2@A3

<p>HARLEY HOUSE BROOKLANDS PARK FARNINGHAM ROAD CROWBOROUGH EAST SUSSEX TN6 2JD Tel: [REDACTED]</p>	<p>Drawing No: C1059-335 Rev: -</p>
---	---

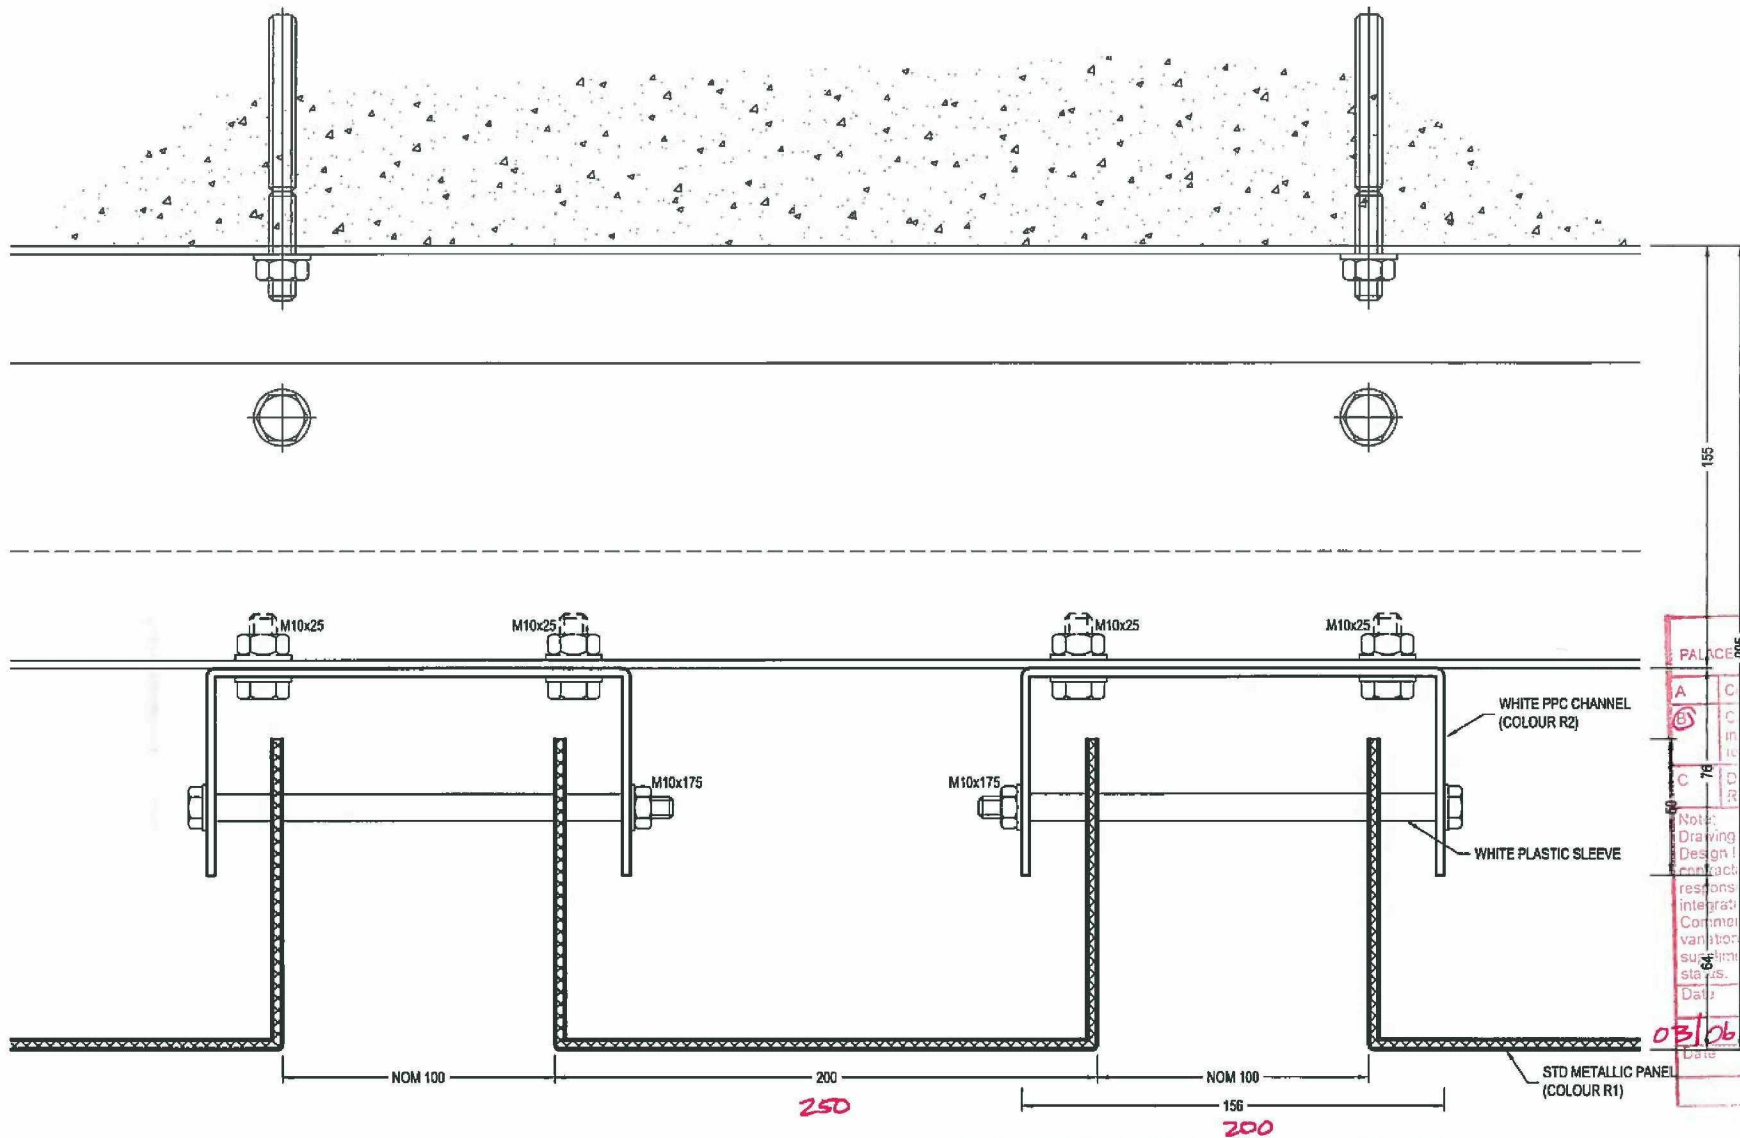

**STUDIO E ARCHITECTS**  
 PALACE 805 HARVEY RAINVILLE ROAD LONDON W8 9HN

A	Confirms to Design Intent
B	Confirms to Design Intent
C	Confirms to Design Intent

**Note:**  
 Drawing status is given for uniformity with outline  
 Design Intent only and does not relieve me  
 contractor/sub-contractor/trade contractor from full  
 responsibility for their design accuracy and  
 integration  
 Comments made do not automatically constitute a  
 variation. Refer to separate specification clause for  
 supplementary information regarding drawing  
 status.

Date	Checked By	Name (Print)
03/06/15	ISINER	NEIL CRAWFORD
Date	Checked By	Name (Print)

IS IT POSSIBLE TO INCREASE THE SPACING ON THESE  
 AS INDICATED SO THEY WILL LOOK MORE LIKE PANNING  
 COLOUR SET (?)

①  
**CROWN PLANKS**

**ISSUED FOR APPROVAL**

FILE 855..


Rev	Date	Notes
-	-	-
-	-	-
-	-	-

DESCRIPTION	
SECTIONS	

PROJECT		
GRENELL TOWER GRENELL RD, LONDON, W11 1TQ		
Drawn By:	Date:	Scale:
bd KVL	11.03.15	1:20A3

<b>harley</b>	
HARLEY HOUSE BROOKLANDS PARK FARNINGHAM ROAD CROWBOROUGH EAST SUSSEX TN6 2JD	
Drawing No:	Rev:
C1059-336	-



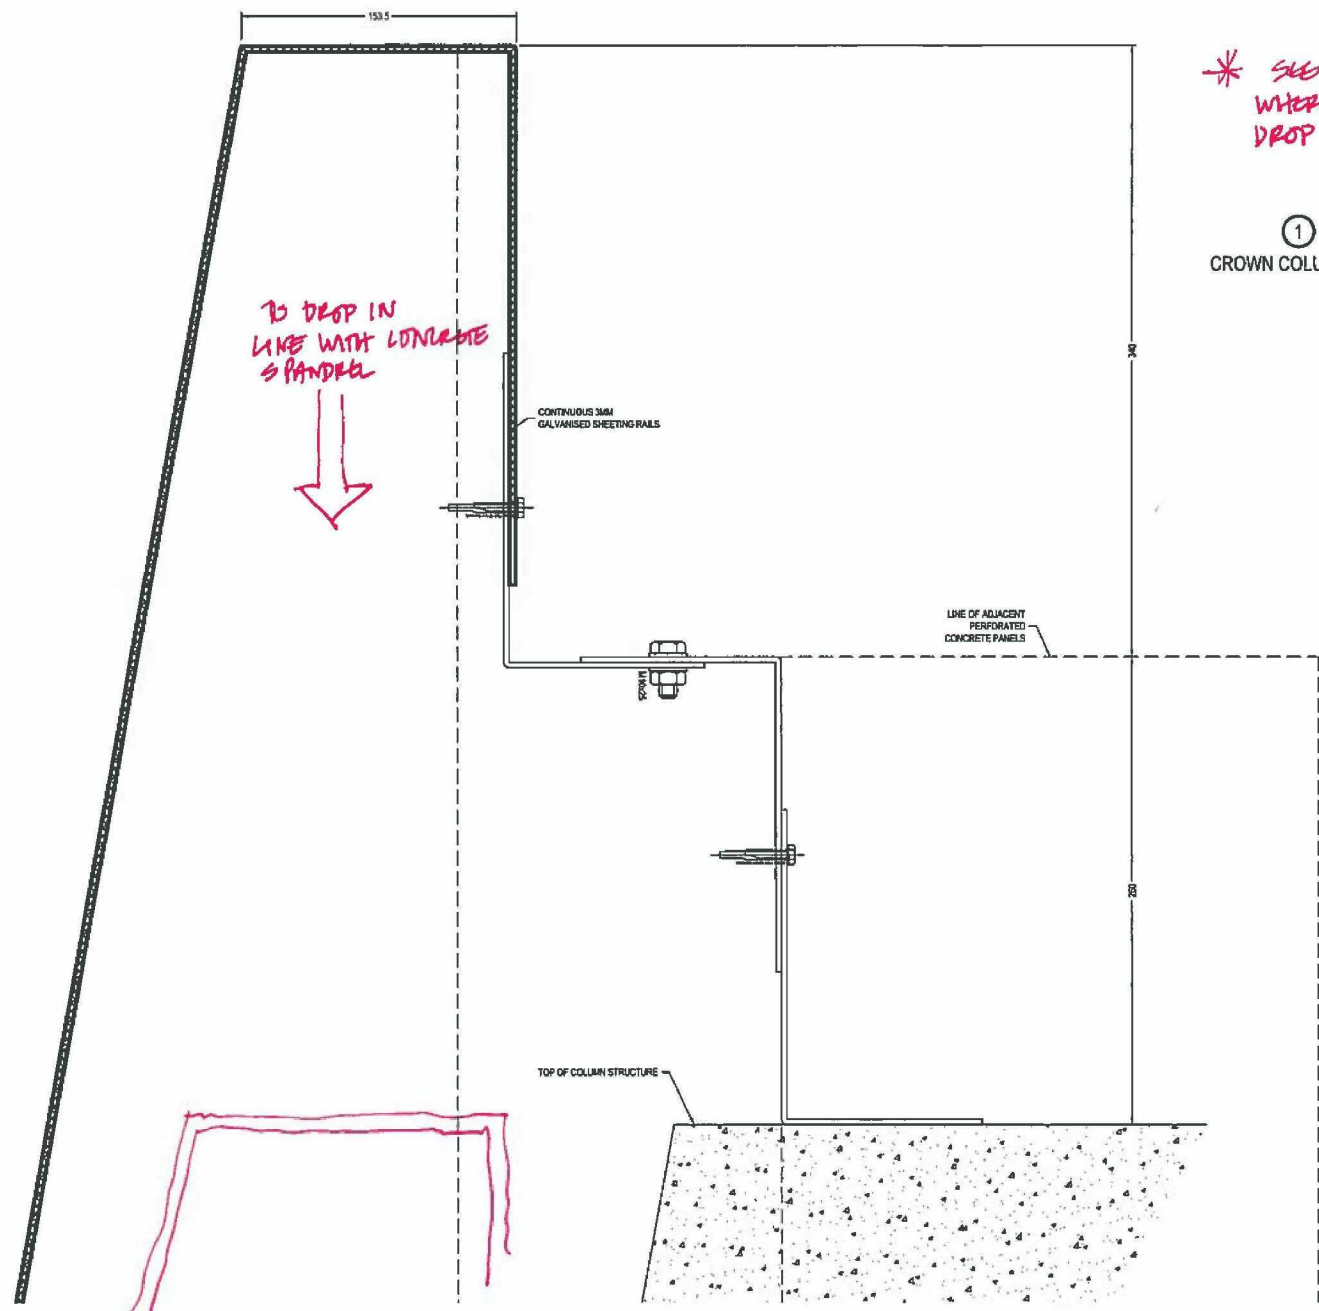

\* SEE COMMENTS ON C1059-334 WHERE CLIENT HAS REQUESTED DROP IN CROWN HEIGHT.

①  
CROWN COLUMN TOP

STUDIO E ARCHITECTS PALACE WHARF RAINVILLE ROAD LONDON W6 9HN		
A	Conforms to Design Intent.	
<b>B</b>	Conforms to Design Intent subject to incorporation of comments. Revise and re-submitting at category A status.	
C	Does not conform with Design Intent. Revise and re-submit.	
<b>Note:</b> Drawing status is given for conformity with outline Design Intent only and does not relieve the contractor/sub-contractor/trade contractor from full responsibility for their design accuracy and integration. Comments made do not automatically constitute a variation. Refer to separate specification clause for supplementary information regarding drawing status.		
Date	Checked By Signature	Name (Print)
03/06/15	<i>[Signature]</i>	NEW ORLANDO
Date	Approved By Signature	Name (Print)

ISSUED FOR APPROVAL

FILE 855..

Rev	Date	Notes
-	-	-
-	-	-
-	-	-

DESCRIPTION: SECTIONS

PROJECT: GRENfell TOWER  
GRENfell RD, LONDON, W11 1TQ

Drawn By: bd KVL  
Date: 11.03.15  
Scale: 1:30@A3

**harley**  
HARLEY HOUSE  
BROOKLANDS PARK  
FARNINGHAM ROAD  
CROWBOROUGH  
EAST SUSSEX  
TN6 2JD  
Tel: [REDACTED]

Drawing No: C1059-337  
Rev: -