


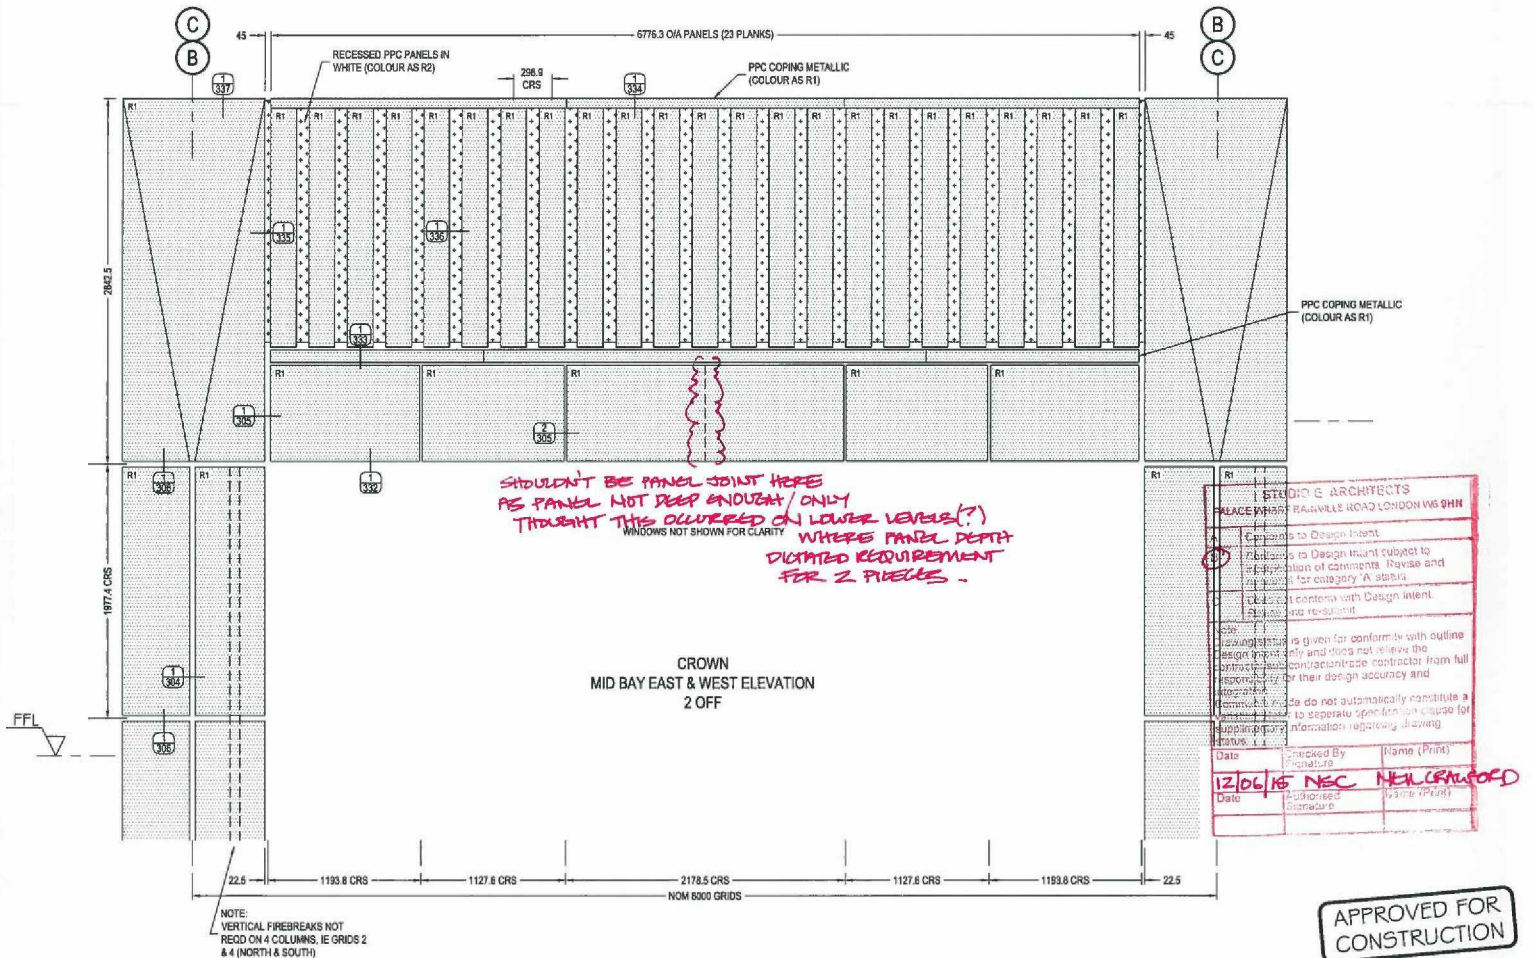

Rev	Date	Notes
1		
2		
3		
4		
5		
6		
7		
8		
9		
10		

ELEVATIONS


Grenfell Tower
Grenfell Rd, London, W11 1TG

Harley House
Brooklands Park
Farnborough Road
Croydon
Surrey
TN6 2JD
Tel: 01892 449784

Drawing No: C1059-216
Rev: -

SEA00003242_0001

SEA00003242/1

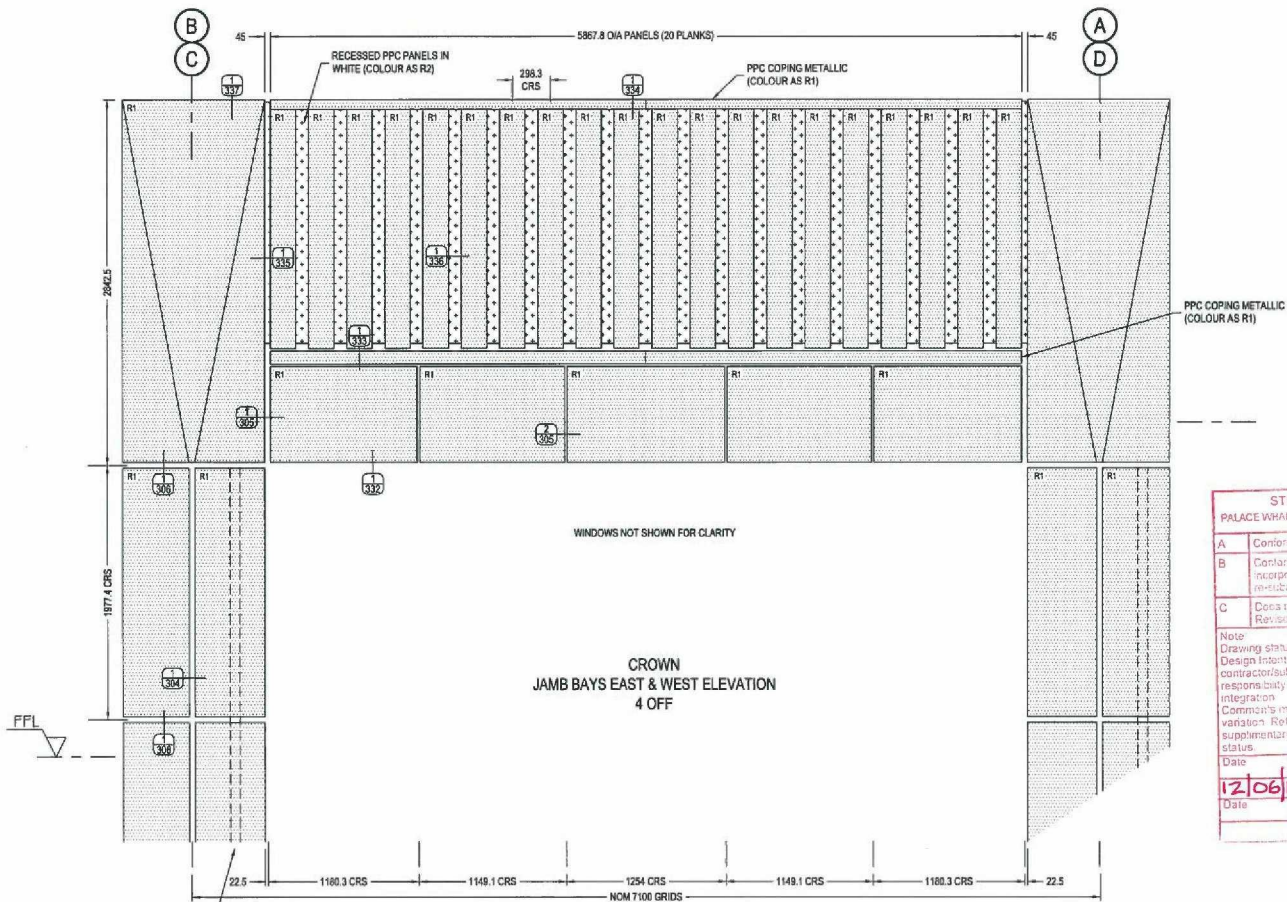


STUDIO S ARCHITECTS PALACE WHARF RAINVILLE ROAD LONDON W15 5HN		
A	Confirms to Design Intent	
B	Confirms to Design Intent subject to incorporation of comments. Revise and resubmit for category 'A' status	
C	Does not conform with Design Intent. Revise and re-submit	
Note: Drawing status is given for conformity with outline Design Intent only and does not relieve the contractor/sub-contractor from full responsibility for their design accuracy and integration. Comments made do not automatically constitute a variation. Refer to separate specification clause for supplementary information regarding drawing status.		
Date	Checked By Signature	Name (Print)
12/06/15	NEC	NEAL O'NEILL
Date	Authorised Signature	Name (Print)

APPROVED FOR
CONSTRUCTION

FILE 665..	ELEVATIONS			Project: GRENELL TOWER GRENELL RD, LONDON, W11 1TQ			 HARLEY HOUSE BROOKLANDS PARK FARNINGHAM ROAD CROWBROUGH EAST SUSSEX TN10 2JD Tel: 01892 449784	Drawing No: C1059-217	Rev: -
	Rev	Date	Notes	Drawn by: bd KVL	Date: 30.09.14	Scale: 1:30@A3			

SEA00003242_0002

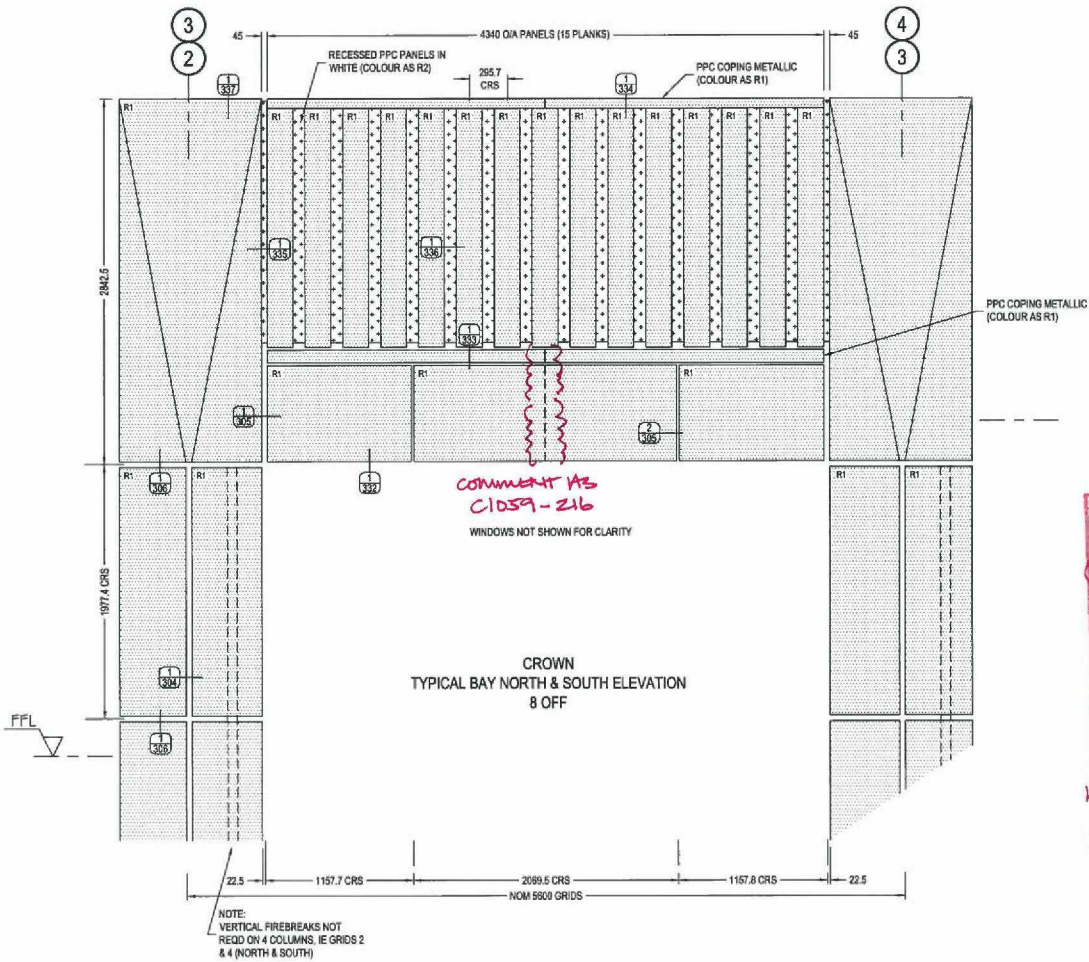

STUDIO E ARCHITECTS PALACE WHARF RAHVILLE ROAD LONDON W6 9HN	
A	Confirms to Design Intent.
B	Confirms to Design Intent subject to incorporation of comments. Revise and re-submit for category 'A' status.
C	Does not conform with Design Intent. Revise and re-submit.
Note: Drawing status is given for conformity with outline Design Intent only and does not relieve the contractor/contractor/trade contractor from full responsibility for their design accuracy and integration. Comments made do not automatically constitute a variation. Refer to separate specification clause for supplementary information regarding drawing status.	
Date	Drawn By
12/06/15	NEC. NALORAWERD.
Name (Print)	Name (Print)


APPROVED FOR
CONSTRUCTION

FIL 055.	ELEVATIONS			Project: GRENELL TOWER GRENELL RD, LONDON. W11 1TQ			 HARLEY HOUSE BROOKLANDS PARK FARNINGHAM ROAD CROYDON SURREY CR9 2JD Tel: 01892 449784	Drawing No: C1059-218 Rev: -
	Rev	Date	Notes	Drawn By: bd KVL	Date: 30.09.14	Scale: 1:308A3		
	-	-	-					
	-	-	-					

SEA00003242_0003




SEA00003242_0004

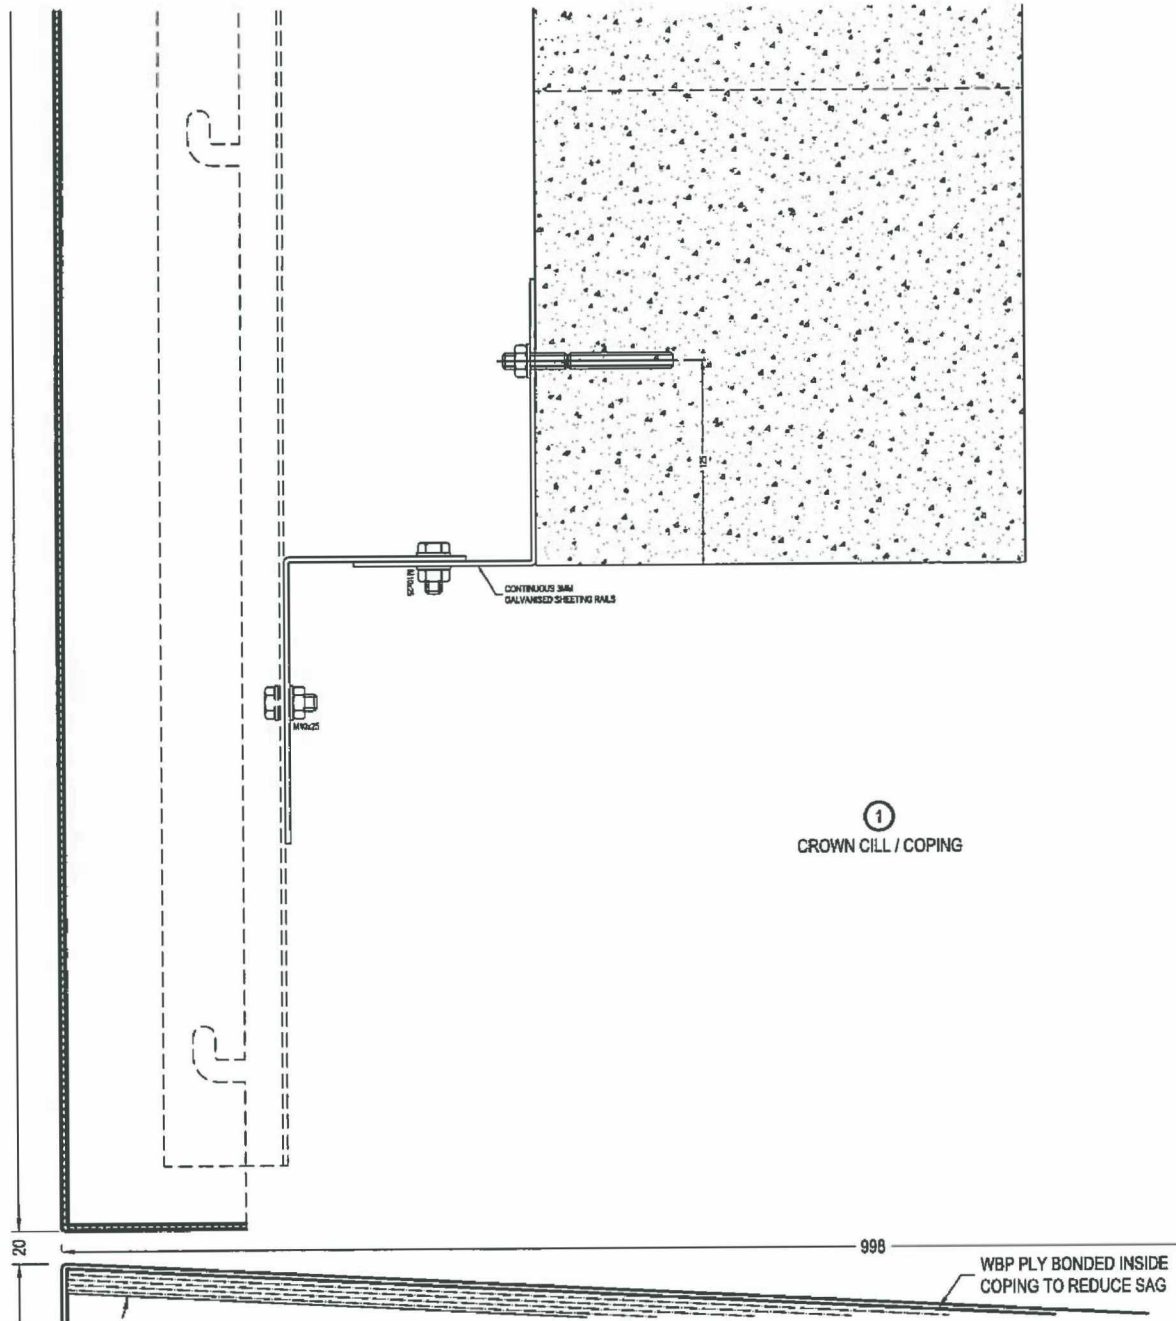

STUDIO E ARCHITECTS PALACE WHARF RAINVILLE ROAD LONDON W6 9HN		
☒ A	Confirms to Design Intent	
☐ B	Confirms to Design Intent subject to incorporation of comments. Revise and re-submit for category 'A' status.	
☐ C	Does not conform with Design Intent. Revise and re-submit.	
Note Drawing status is given for conformity with outline Design Intent only and does not relieve the contractor/sub-contractor/ade contractor from full responsibility for their design accuracy and integration. Comments made do not automatically constitute a variation. Refer to separate specification clause for supplementary information regarding drawing status.		
Date	Checked By	Name (Print)
12/06/15	NEC	NEAL RUFORD
Date	Approved By	Name (Print)


ISSUED FOR
APPROVAL

FILE 855..		DESCRIPTION		PROJECT		DRAWN BY		DATE		SCALE		PROJECT		
Rev	Date	Notes	SECTIONS		GRENFELL TOWER GRENFELL RD, LONDON. W11 1TQ		bd KVL		11.03.15		1:4@A3		harley HARLEY HOUSE BROOKLANDS PARK FARNINGHAM ROAD CROWBOROUGH EAST SUSSEX TN4 2JD Tel: 01892 669784	
												Drawing No: C1059-333 Rev: -		

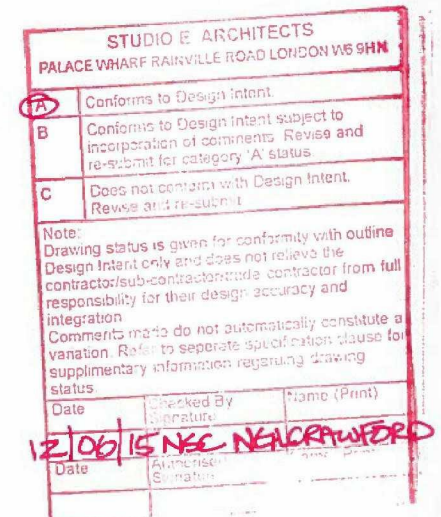

ISSUED FOR
APPROVAL

FILE 855..	-	-	-	DESCRIPTIONS SECTIONS	PROJECT GRENFELL TOWER GRENFELL RD, LONDON. W11 1TQ	 HARLEY HOUSE BROOKLANDS PARK BARNINGHAM ROAD CROWBOROUGH EAST SUSSEX TN4 2JD Tel: 01892 669784	Drawing No: C1059-334	Rev:
	-	-	-					
	-	-	-					
	-	-	-					
	Rev	Date	Notes					

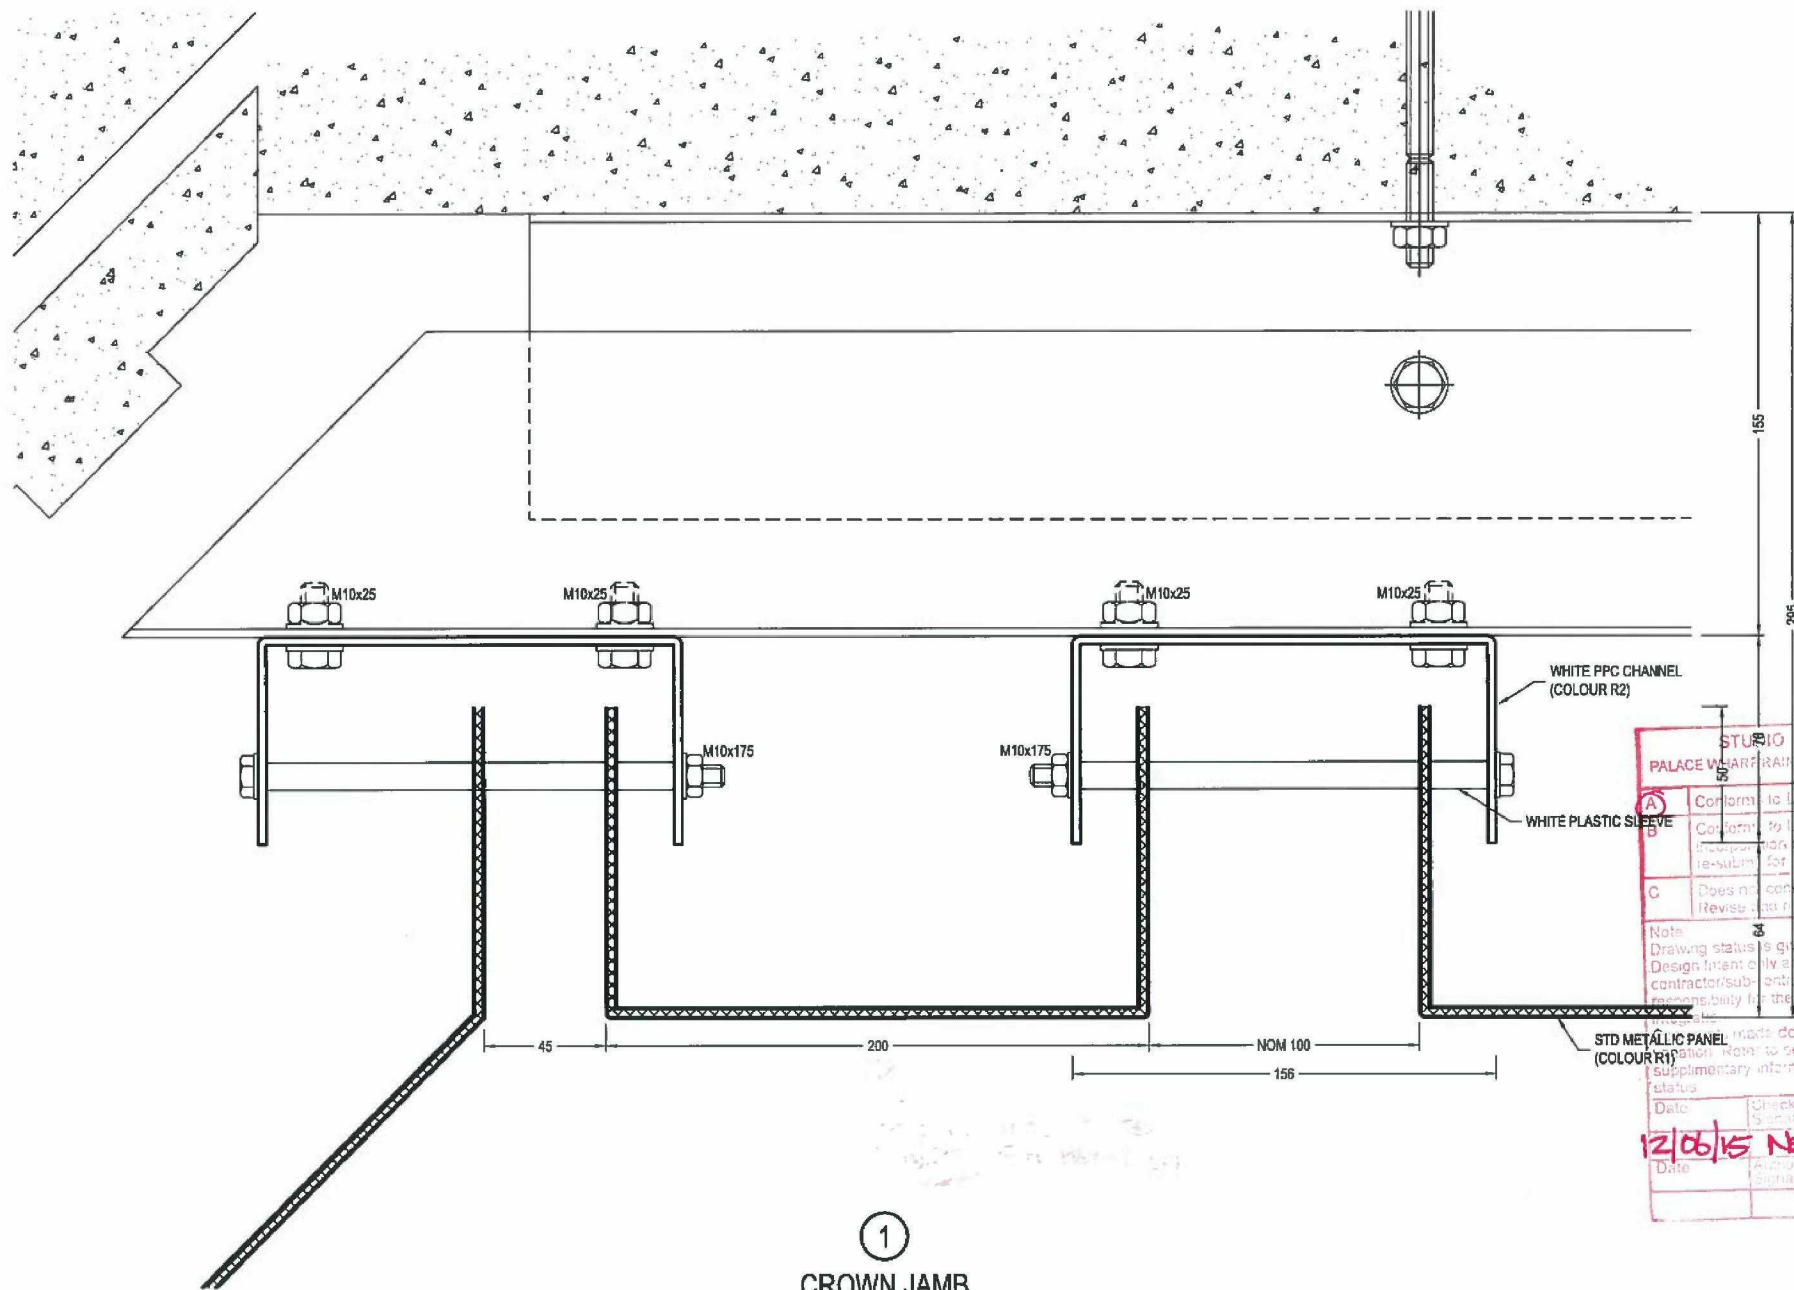

①
CROWN JAMB

STUDIO 3 ARCHITECTS
PALACE WHARF, RAIPVILLE ROAD LONDON W5 9HN

A	Conforms to Design Intent
B	Conforms to Design Intent subject to incorporation of comments. Revise and re-submit for category 'A' status
C	Does not conform with Design Intent. Revise and re-submit

Note:
Drawing status is given for conformity with outline Design Intent only and does not relieve the contractor/sub-contractor from full responsibility for the design accuracy and integrity.

STD METALLIC PANEL (COLOUR R1)

Date	Checked By Signature	Name (Print)
12/06/15	NEC	NEC
Date	Authorised Signature	Name (Print)

ISSUED FOR
APPROVAL

FILE 855...

Rev	Date	Notes
-	-	-
-	-	-
-	-	-

Description:

SECTIONS

Project:

GRENELL TOWER
GRENELL RD, LONDON. W11 1TQ

Drawn By:
bd KVL


Date:
11.03.15

Scale:
1:20A3

harley
HARLEY HOUSE
BROOKLANDS PARK
FARNINGHAM ROAD
CROWBOROUGH
EAST SUSSEX
TN11 2JD
Tel: 01892 669784

Drawing No:
C1059-335


Rev:

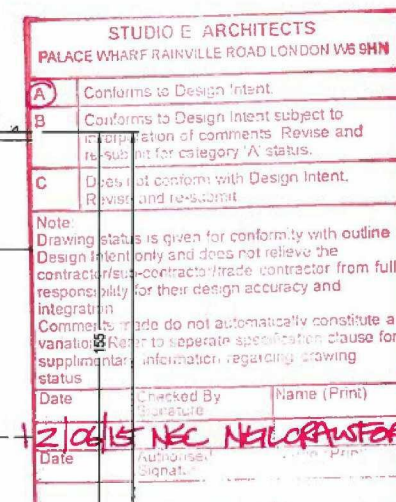

①
CROWN PLANKS

ISSUED FOR
APPROVAL

FILE 855..	-	-	-	Description: SECTIONS	Project: GRENFELL TOWER GRENFELL RD, LONDON. W11 1TQ	 HARLEY HOUSE BROOKLANDS PARK FARNINGHAM ROAD CROWBOROUGH EAST SUSSEX TN6 2JD TEL: 01822 669784	Drawing No: C1059-336	Rev:
	-	-	-					
	-	-	-					
	-	-	-					
	Rev	Date	Notes					

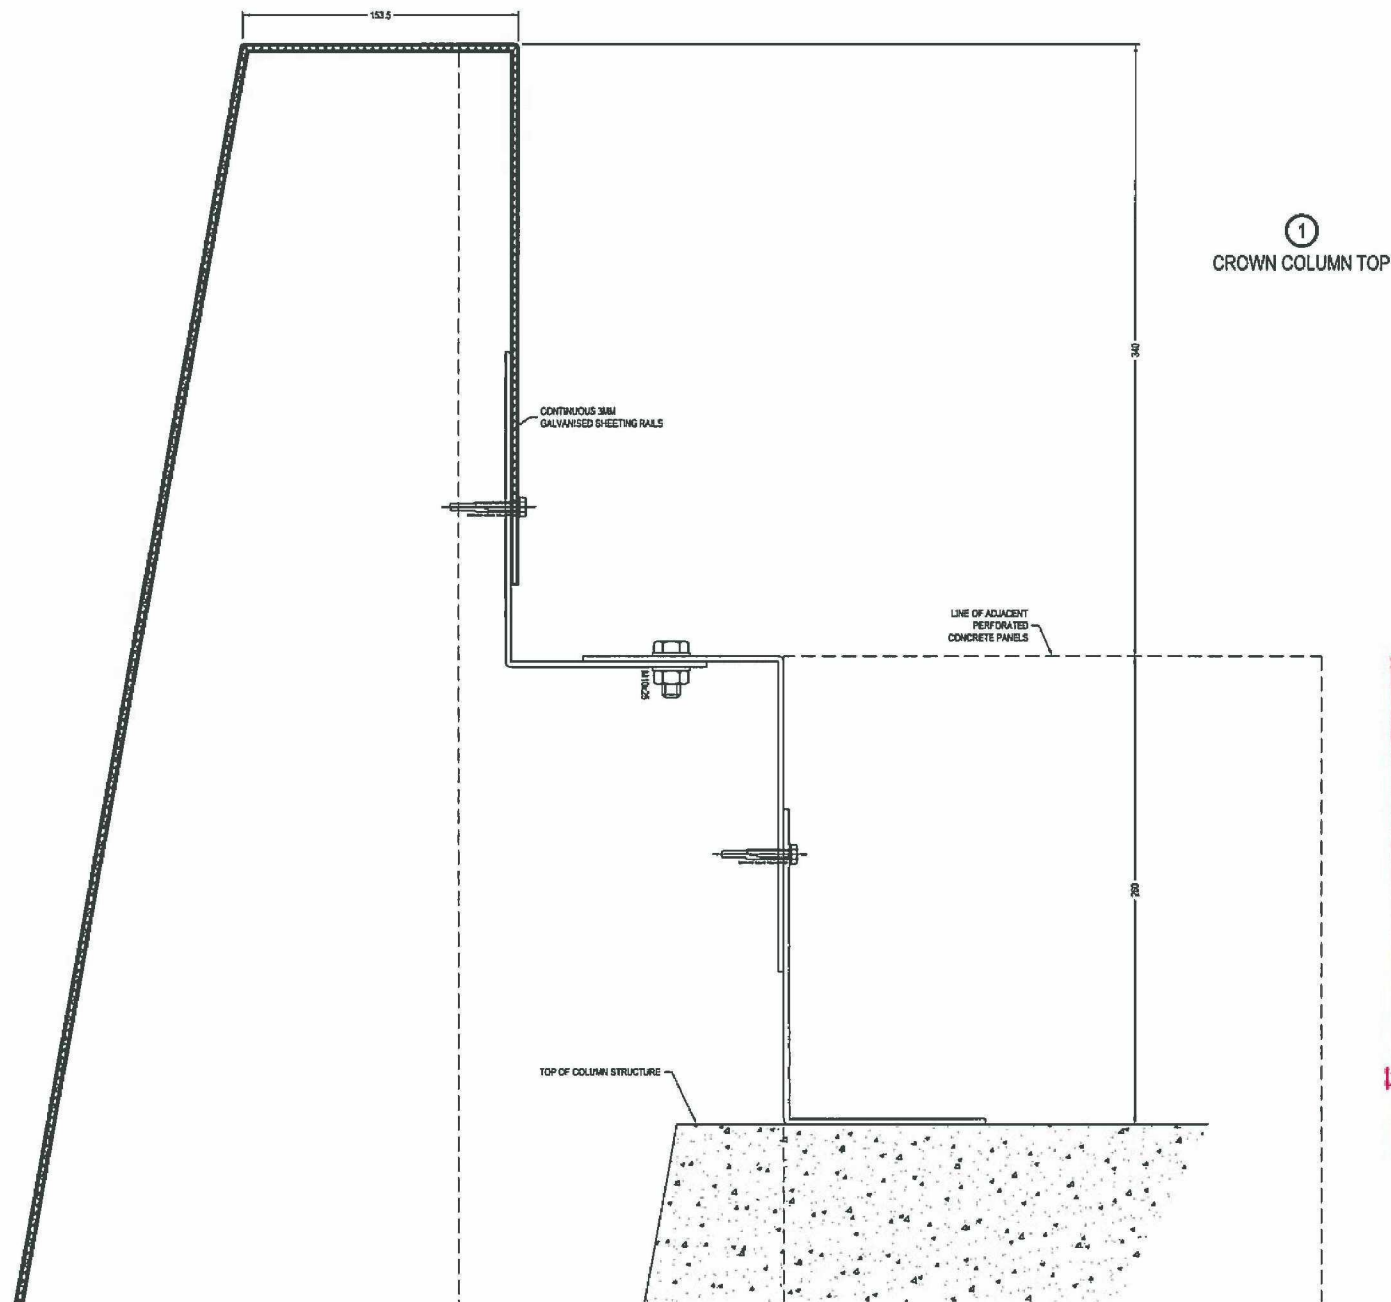

STUDIO E ARCHITECTS PALACE WHARF RAHVILLE ROAD LONDON W16 9HN		
A	Conforms to Design Intent.	
B	Conforms to Design Intent subject to incorporation of comments. Revise and re-submit for category 'A' status.	
C	Does not conform with Design Intent. Revise and re-submit.	
Note: Drawing status is given for conformity with outline Design Intent only and does not relieve the contractor/sub-contractor/trade contractor from full responsibility for their design accuracy and integration. Comments made do not automatically constitute a variation. Refer to separate specification clause for supplementary information regarding drawing status.		
Date	Checked By Signature	Name (Print)
12/06/15	NEC	NEIL CRAWFORD
Date	Approved By Signature	Name (Print)

ISSUED FOR
APPROVAL

FILE 855..

Rev	Date	Notes
-	-	-
-	-	-
-	-	-

Description:

SECTIONS

Project:

GRENELL TOWER
GRENELL RD, LONDON, W11 1TQ

Drawn By:
bd KVL

Date:
11.03.15

Scale:
1:30@A3

harley
HARLEY HOUSE
BROOKLANDS PARK
FARNINGHAM ROAD
CROWBOROUGH
EAST SUSSEX
TN6 2JD
Tel: 01892 669784

Drawing No:
C1059-337

Rev:

-