

**APPROVED FOR CONSTRUCTION**

**harley**  
 HARLEY HOUSE  
 BROOKLANDS PARK  
 FARNINGHAM ROAD  
 CROWBOROUGH  
 EAST SUSSEX  
 TN6 2JD  
 Tel: [REDACTED]

Drawing No: C1059-219 Rev: E

Project: **GRENFELL TOWER**  
**GRENFELL RD, LONDON. W11 1TQ**

Drawn By: **bd KVL** Date: **05.07.15** Scale: **1:30@A3**

Description: **ELEVATIONS**

Rev	Date	Notes
E	26.08.15	2 OFF TRANSOMS REMOVED
D	26.08.15	DOOR TRANSOM RAISED 60MM
C	25.08.15	REFERENCE CLADDING
B	25.08.15	DOOR TRANSOM LOWERED 60MM
A	18.08.15	LEVELS, ENTRANCE REDRAWN, CONS

FILE 855..

**STATION E. ARCHITECTS**  
 PALACE WAREHOUSE RAMBLE ROAD, 115 MILLON WAY 94NN

28/08/15

Checked By: [Signature] Name (Print): **NBC**

Authorised Signature: [Signature] Name (Print):


Date: 28/08/15

**A** Confirms to Design intent

**B** Corrected to Design intent. Subject to re-submission. Revise and resubmit.

**C** Does not conform with Design Intent. Revise and re-submit.

Notes: [REDACTED]

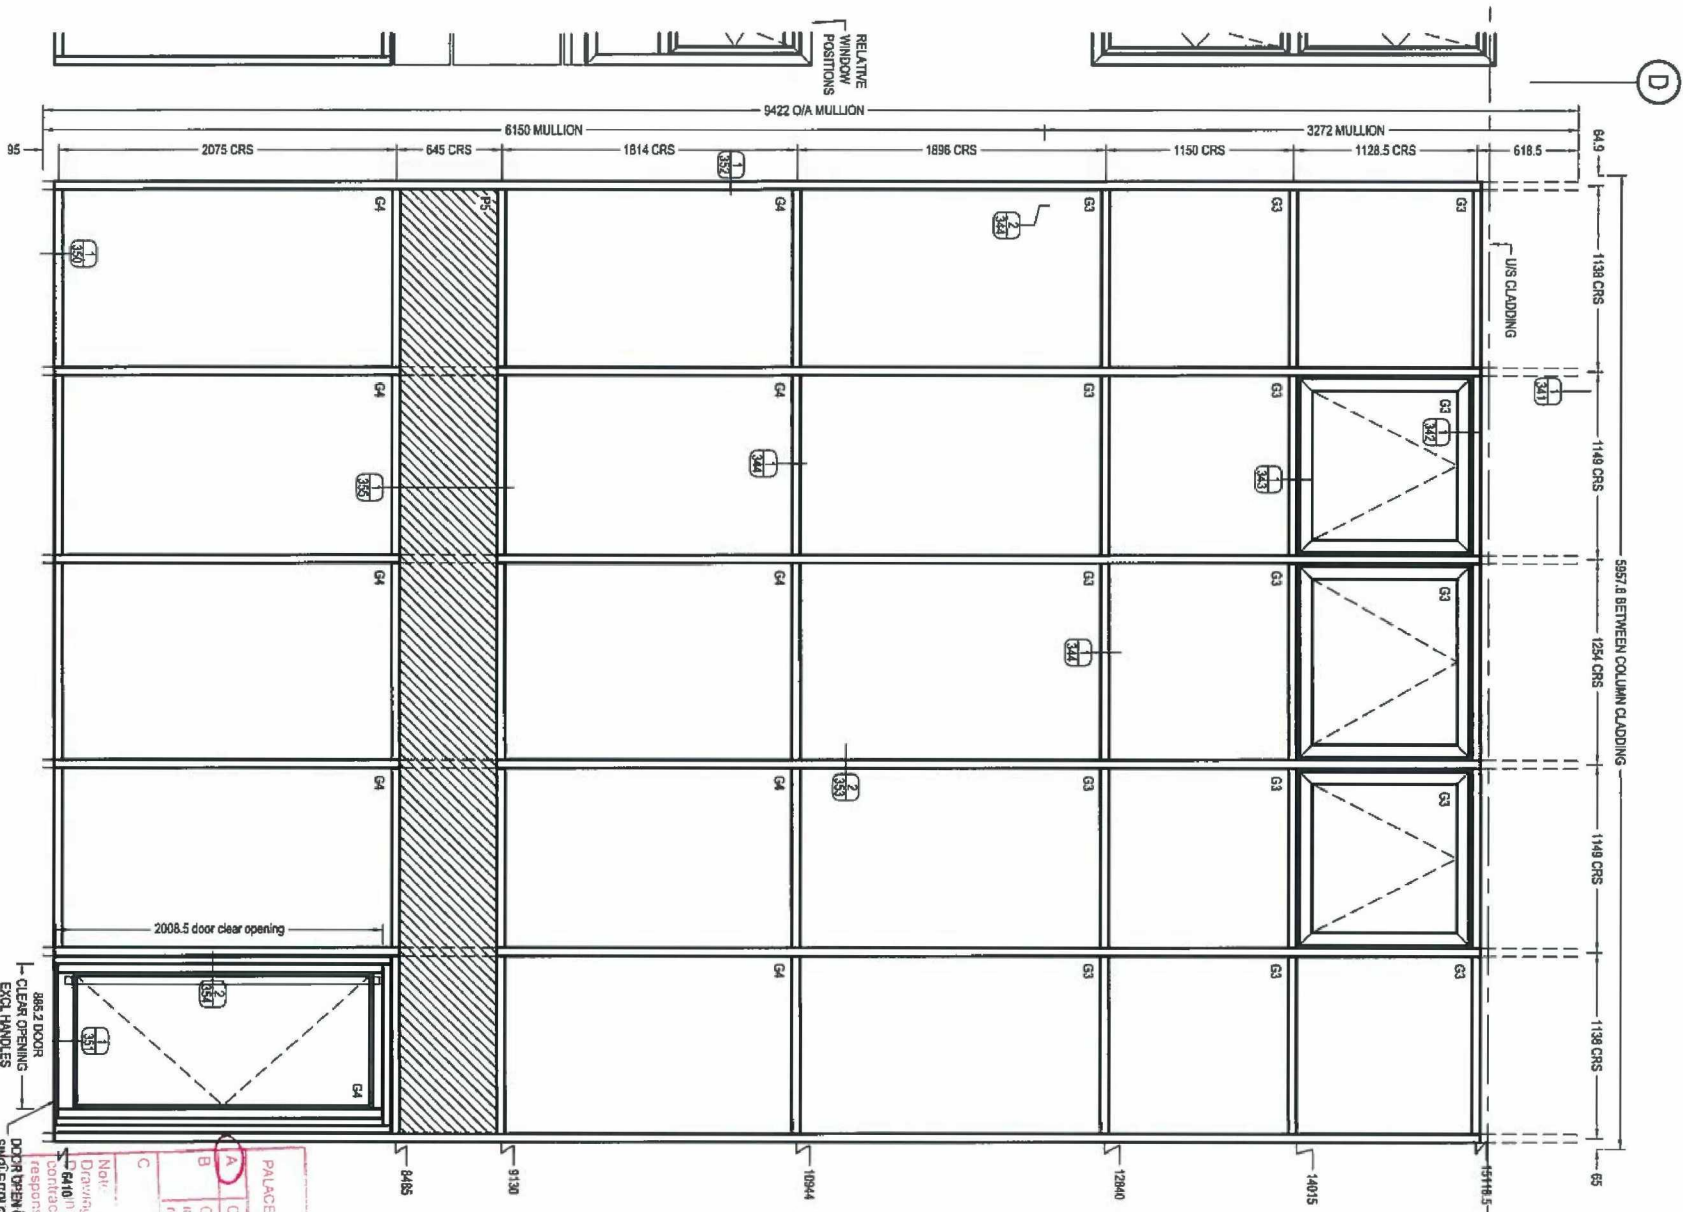

**APPROVED FOR CONSTRUCTION**

Rev	Date	Notes
D	26.08.15	DOOR NOTE ADDED
C	26.08.15	DOOR TRANSOM RAISED 60MM
B	25.08.15	DOOR TRANSOM LOWERED 60MM
A	18.08.15	LEVELS, CONSTRUCTION

DESCRIPTION: ELEVATIONS

PROJECT: GRENPELL TOWER  
GRENPELL RD, LONDON. W11 1TQ

Drawn By: **bd** KVL Date: 05.07.15 Scale: 1:30@A3

Project: **harley**  
HARLEY HOUSE  
BROOKLANDS PARK  
FARNINGHAM ROAD  
CROWBOROUGH  
EAST SUSSEX  
TN4 2JD  
Tel: [REDACTED]

Drawing No: C1059-221 Rev: D

FILE 0655.

STUDIO E ARCHITECTS  
PALACE WHARF RAHVILLE ROAD LONDON W6 9HN

**A** Conforms to Design Intent


**B** Conforms to Design Intent subject to incorporation of comments. Revise and re-submit for equal A status

**C** Conforms with Design Intent.

Notes:  
Drawing is to be used for construction only. It is not to be used for any other purpose without the written consent of the architect.  
The architect's liability is limited to the design and construction of the building and its fixtures and fittings.  
The architect is not responsible for any delay or cost incurred by the contractor or any other party as a result of any error or omission in this drawing.

DOOR OPEN OUT SINGLE COLOR / MAKE UP GLASS / TRANSLUCENT GLASS / TRANSPARENT GLASS / TRANSPARENT GLASS WITH VARIATION. Note: The architect is not responsible for any delay or cost incurred by the contractor or any other party as a result of any error or omission in this drawing.

Checked By: [Signature] Name (Print): [Name]  
Date: 26/08/15  
Authorised Signature: [Signature] Name (Print): [Name]  
Date: 26/08/15

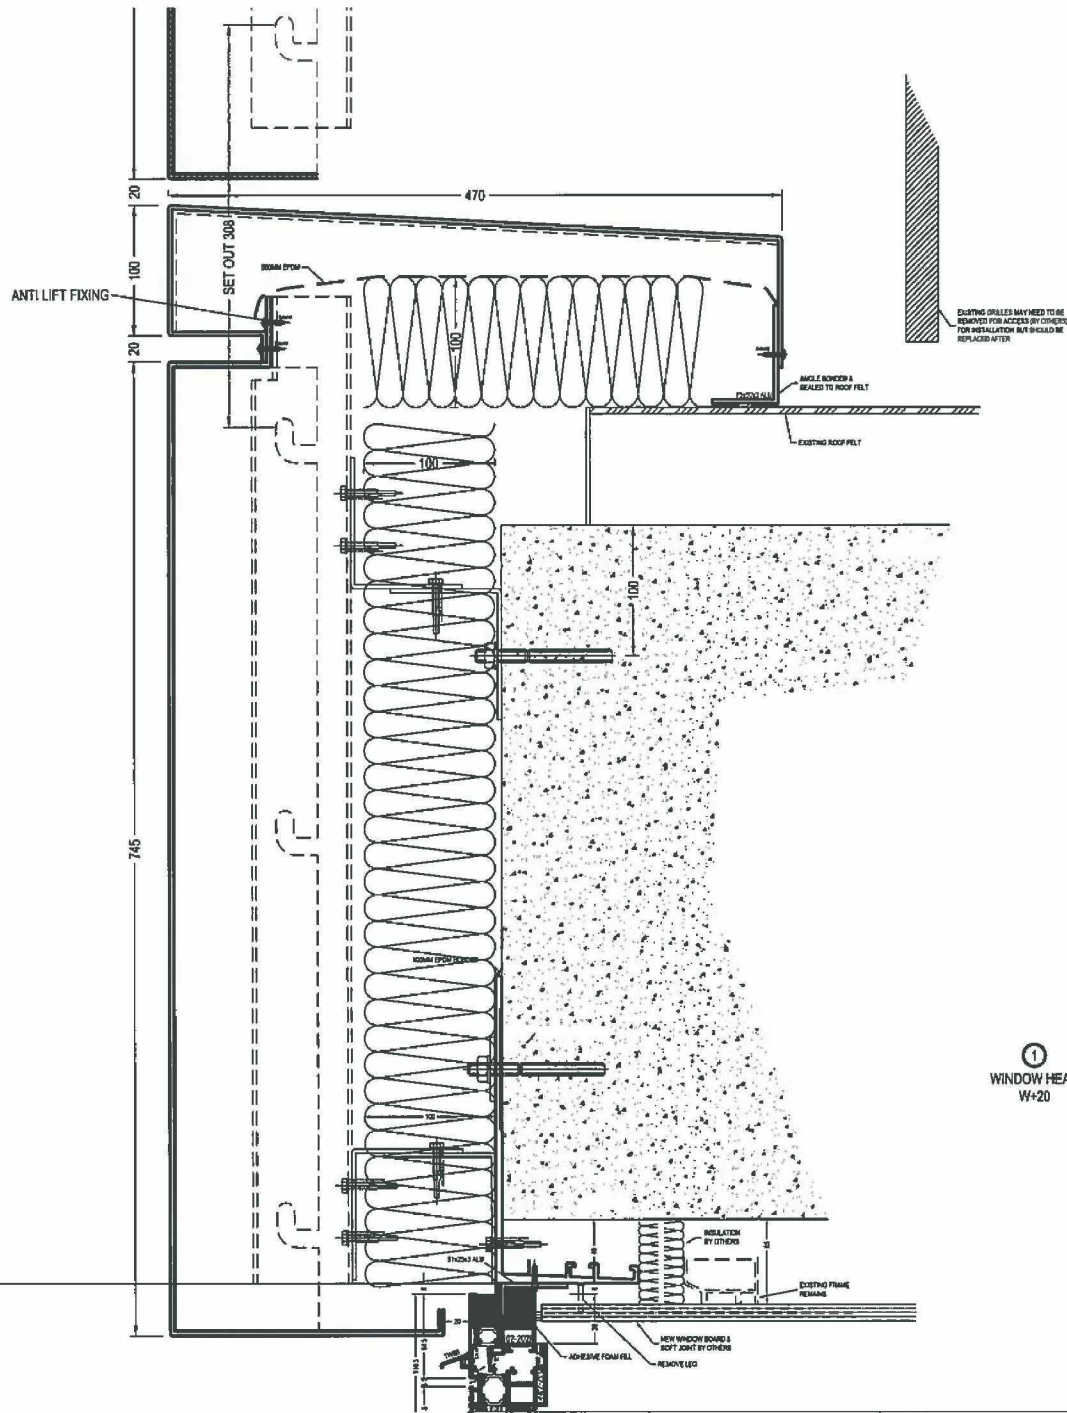

①  
WINDOW HEAD / COPING  
W+20

STUDIO E ARCHITECTS PALACE WHARF RAINVILLE ROAD LONDON W6 9HN		
<input checked="" type="radio"/>	Conforms to Design Intent	
B	Conforms to Design intent subject to incorporation of comments. Revise and re-submit for category A status	
C	Does not conform with Design Intent. Revise and re-submit	
Note: Drawing status is given for conformity with outline Design Intent only and does not relieve the contractor/sub-contractor/trade contractor from full responsibility for their design accuracy and integration. Comments made do not automatically constitute a variation. Refer to separate specification clause for supplementary information regarding drawing status.		
Date	Checked By	Name (Print)
28/08/15		NSC
Date	Author's Signature	Name (Print)

ISSUED FOR APPROVAL

FILE 855.

Rev	Date	Notes
-	-	-
B	26.08.15	RAIL SET OUT ADDED
A	01.07.15	COPING REDRAWN

SECTION

DESCRIPTION	SECTIONS
PROJECT	GRENFELL TOWER GRENFELL RD, LONDON, W11 1TQ
DRAWN BY	bd KVL
DATE	11.03.15
SCALE	1:4@A3

PROJECT	GRENFELL TOWER GRENFELL RD, LONDON, W11 1TQ
DRAWN BY	bd KVL
DATE	11.03.15
SCALE	1:4@A3

<b>harley</b> HARLEY HOUSE BROOKLANDS PARK FARNINGHAM ROAD CROWBOROUGH EAST SUSSEX TN4 2JD Tel:	Drawing No:	Rev:
	C1059-332	B