





1 Entrance Lobby Pendant Lights

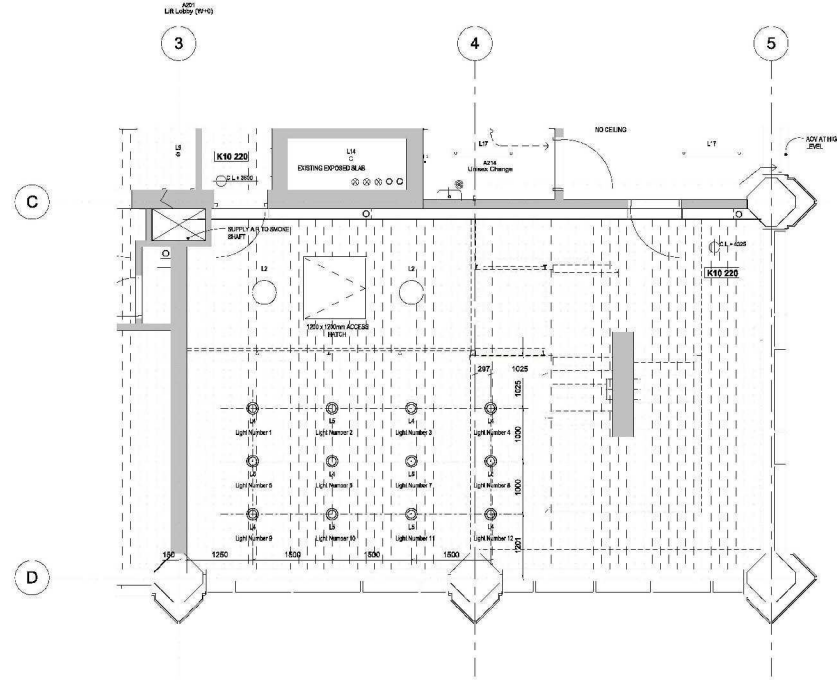

2 Entrance Lobby RCP
1 : 50

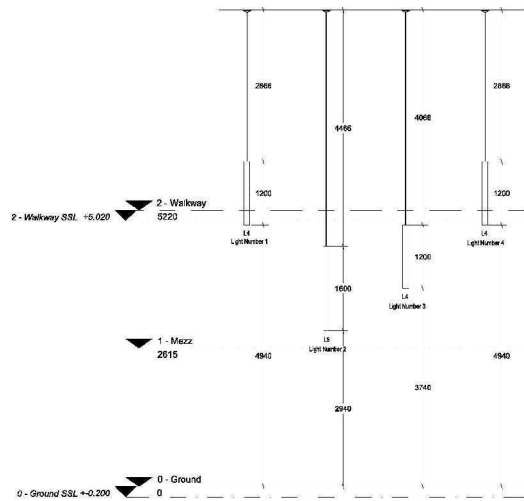

3 Pendant Lights Setting out
1 : 50

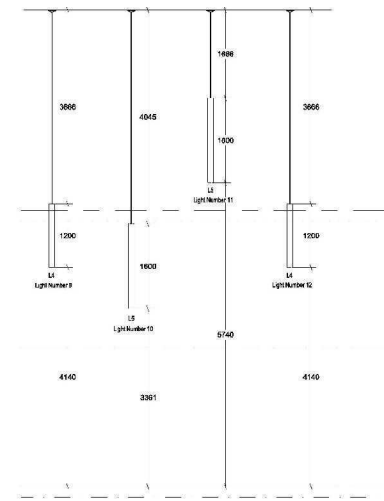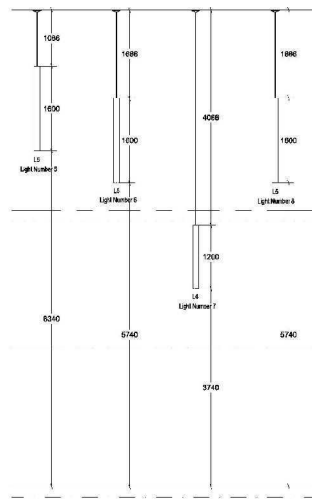

NOTE:
1 THIS DRAWING IS COPYRIGHT STUDIO E LLP.
2 THE CONTRACTORS MUST NOT SCALE FROM THE DRAWING. ALL DIMENSIONS TO BE TAKEN FROM DIMENSION STRINGS.
3 WHERE ANY DISCREPANCIES ARE FOUND BETWEEN DIMENSIONS THESE MUST BE BROUGHT FORWARD TO THE ATTENTION OF THE ARCHITECTS FOR RESOLUTION.
4 WHERE DISCREPANCIES EXIST BETWEEN REFERENCE OR ASSEMBLY DRAWINGS & DETAIL DRAWINGS, THE LATTER TAKE PRECEDENCE.

01 01 12 15 Lobby Pendant Lights Setting Out

AS BUILT



STUDIO E LLP

www.studioe.co.uk
GRENFELL TOWER
REGENERATION PROJECT
PROJECT
Entrance Lobby Light Set
Out
DRAWINGS

1 : 50 01/12/15
SCALE DATE
(70) 100 01 Checker
DWG. NO. REVISION CHECKED

01/22/2015 11:31:14