





1 Kitchen elevation 1
1:20

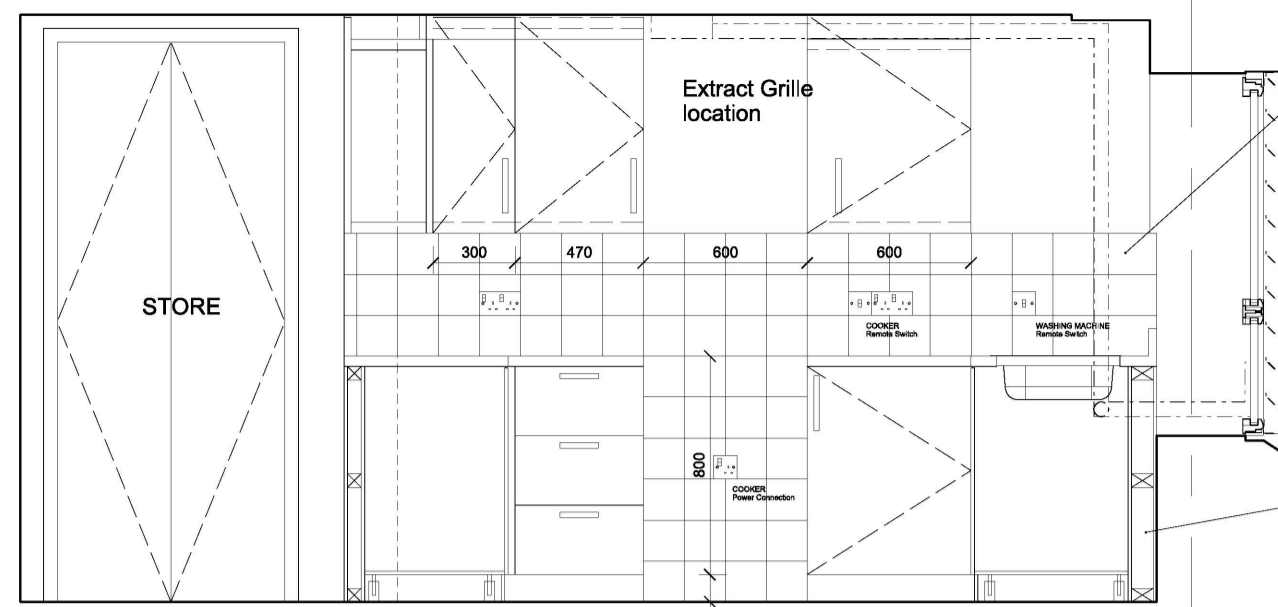


2 Kitchen elevation 2
1:20

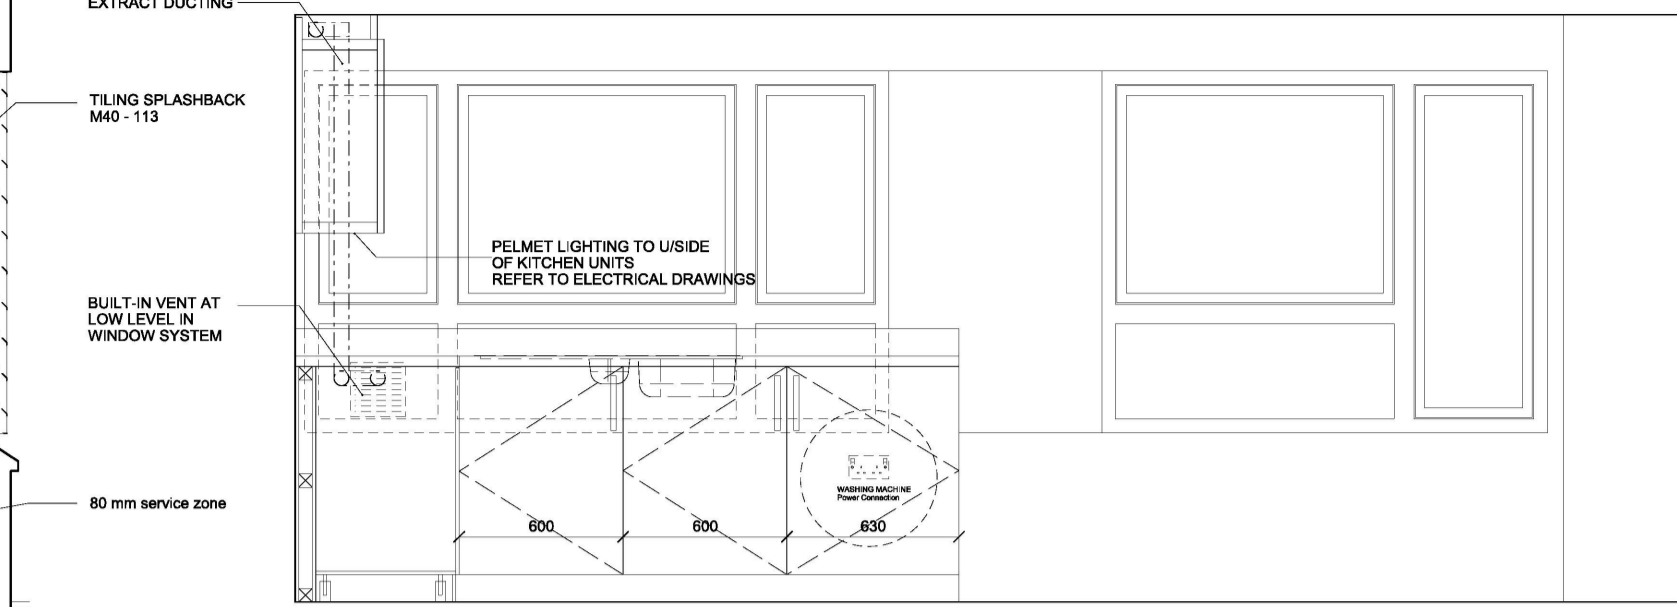

3 Kitchen Elevation 3
1:20

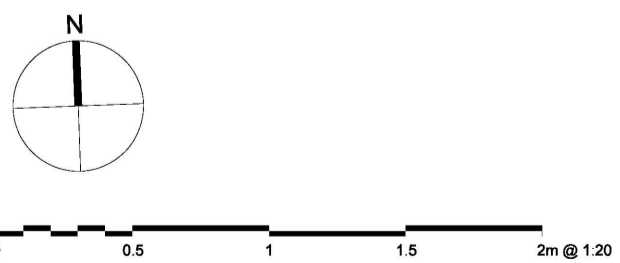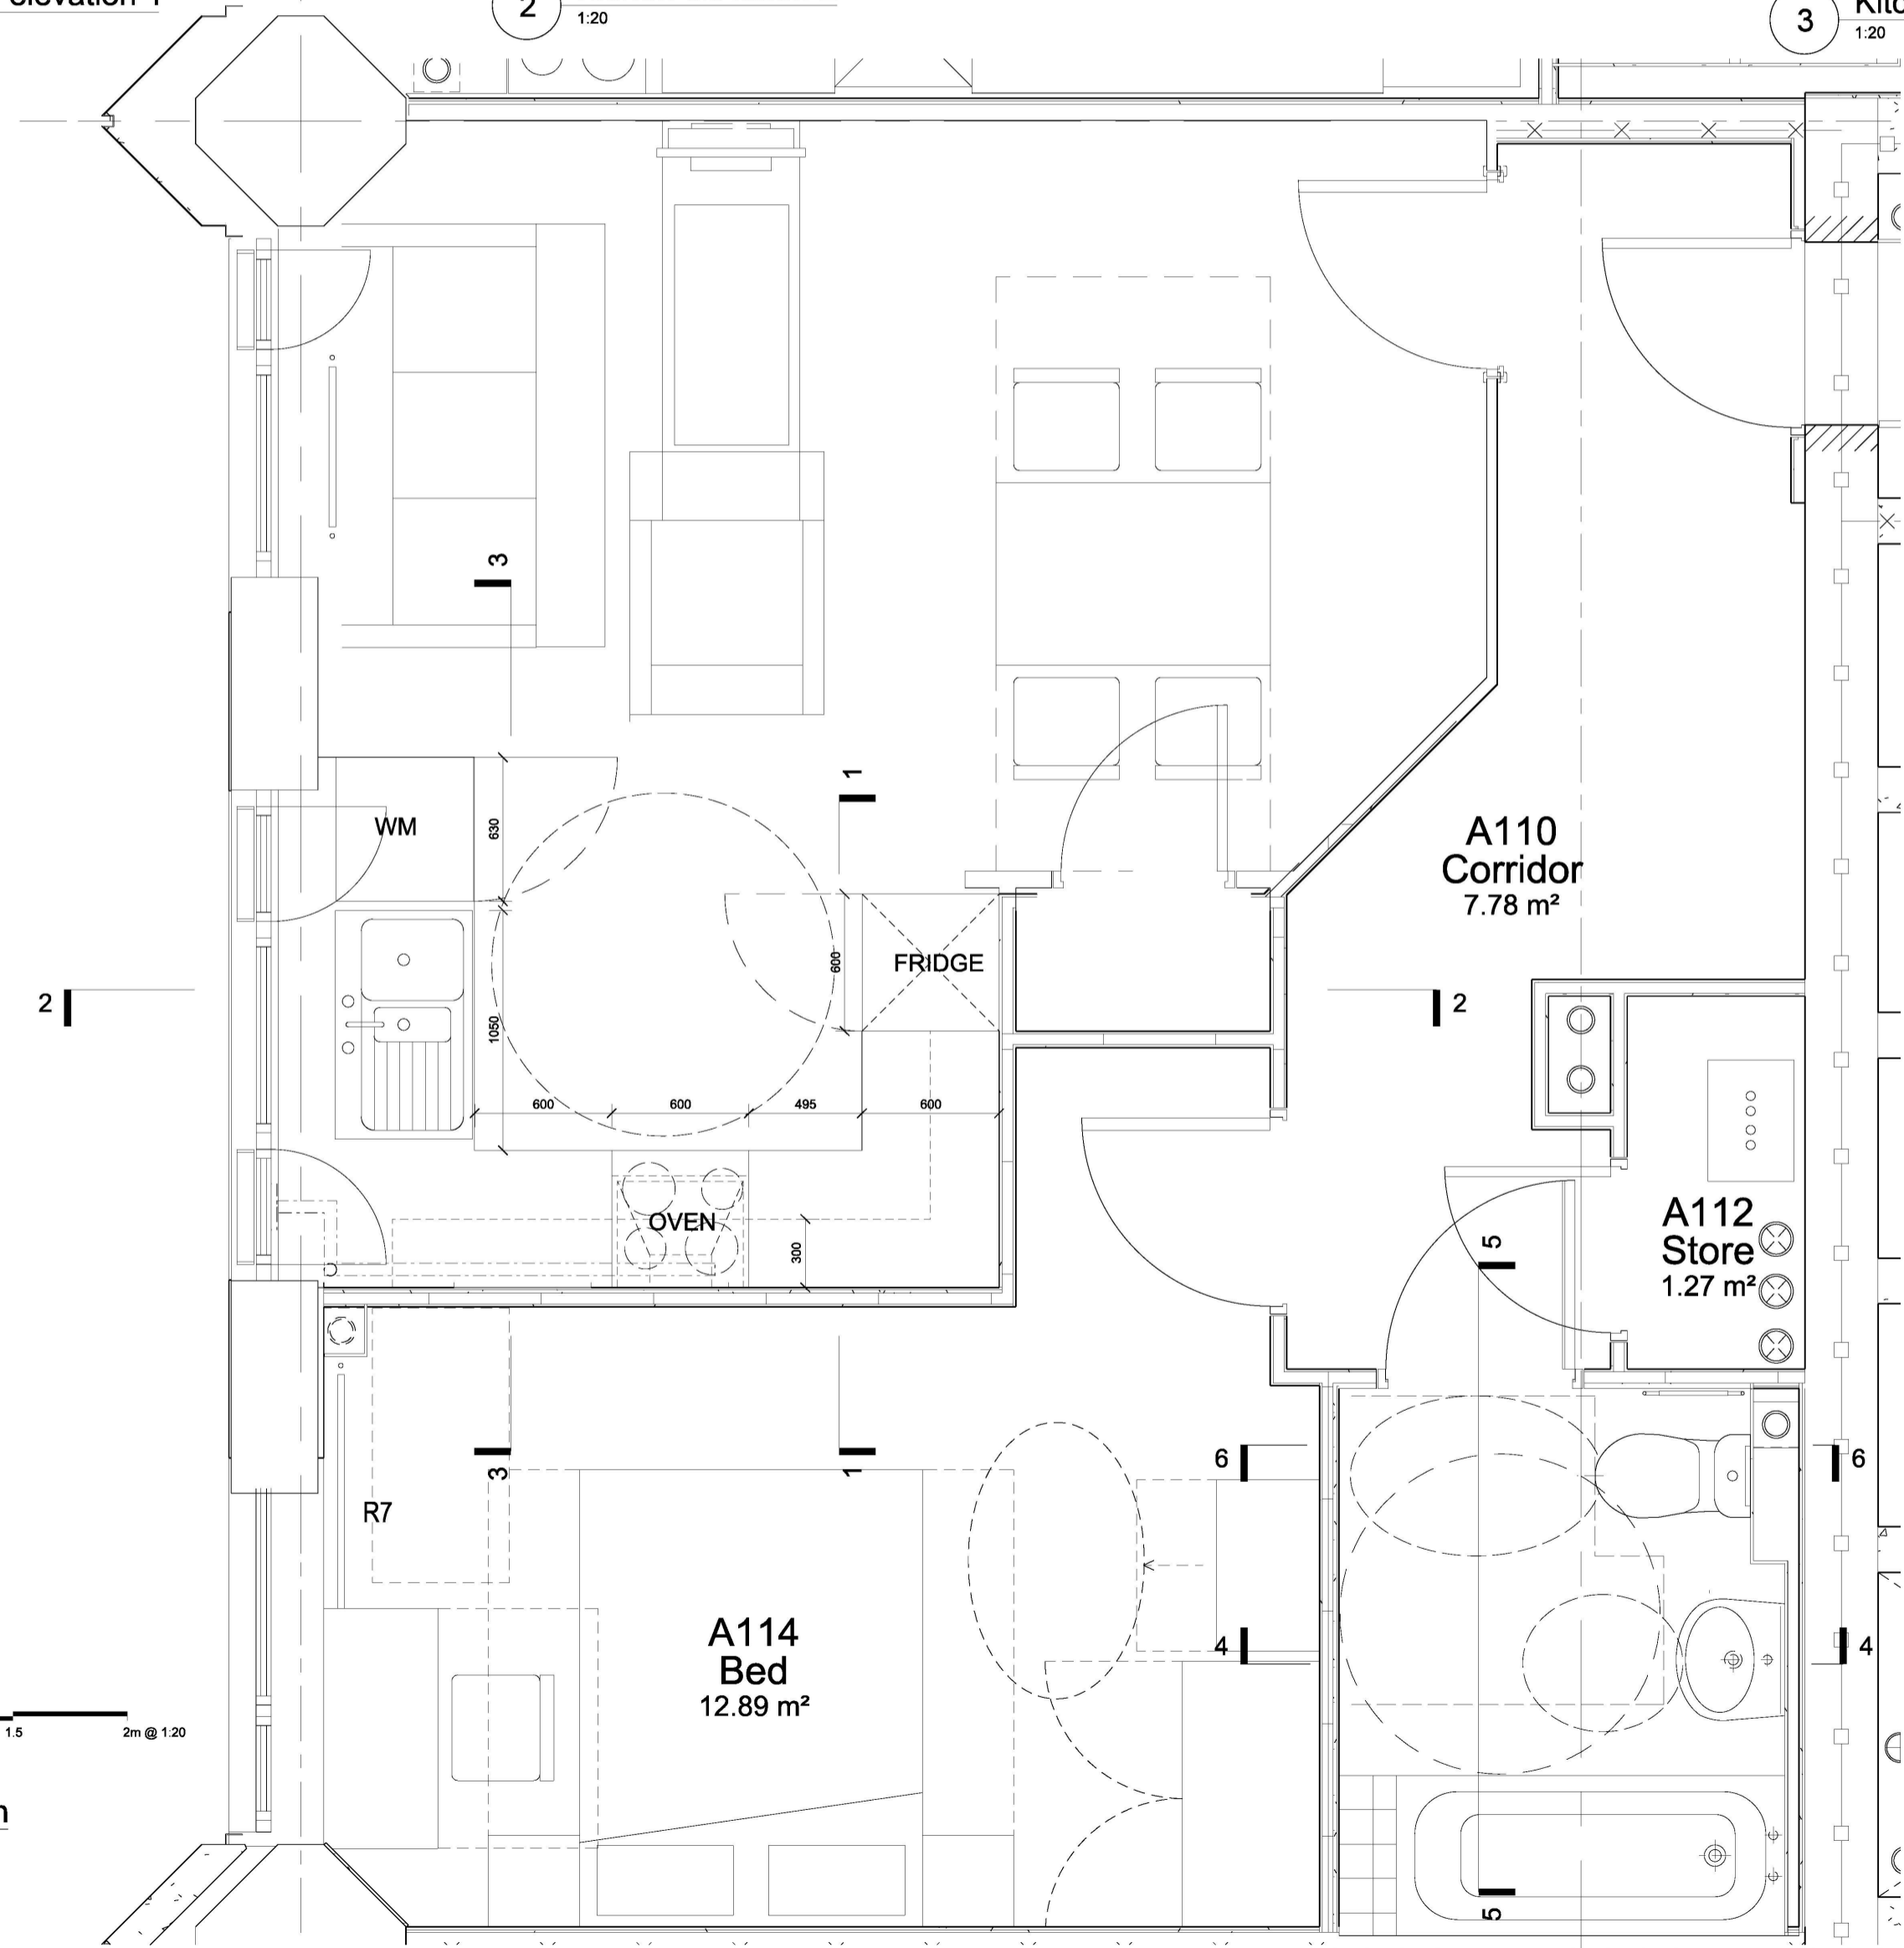


7 Flat Type 3 Plan
1:20

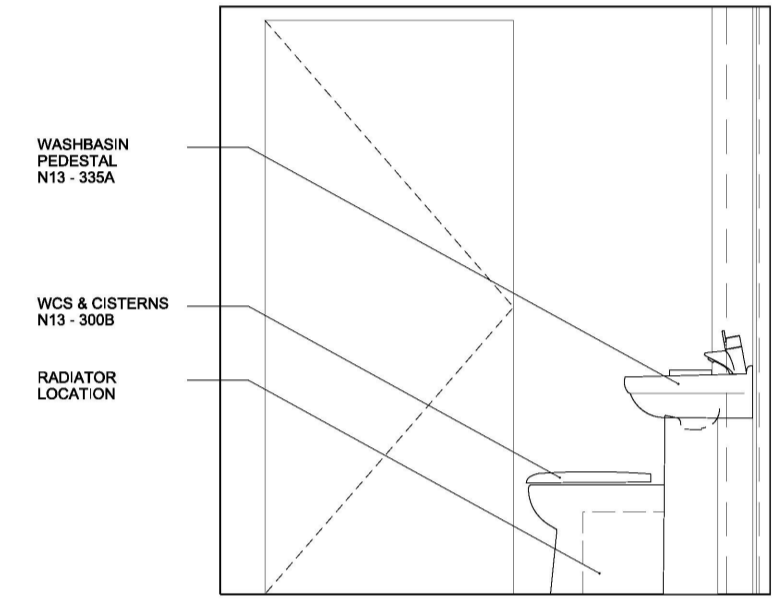


4 Bathroom 1
1:20

- SHOWER CURTAIN RAIL N13 - 375C
- TILING M40 - 112
- MIRROR N10 - 270
- TAP MIXER N13 - 335A
- WASHBASIN PEDESTAL UNIT N13 - 335A
- WCS & CISTERNS N13 - 300B

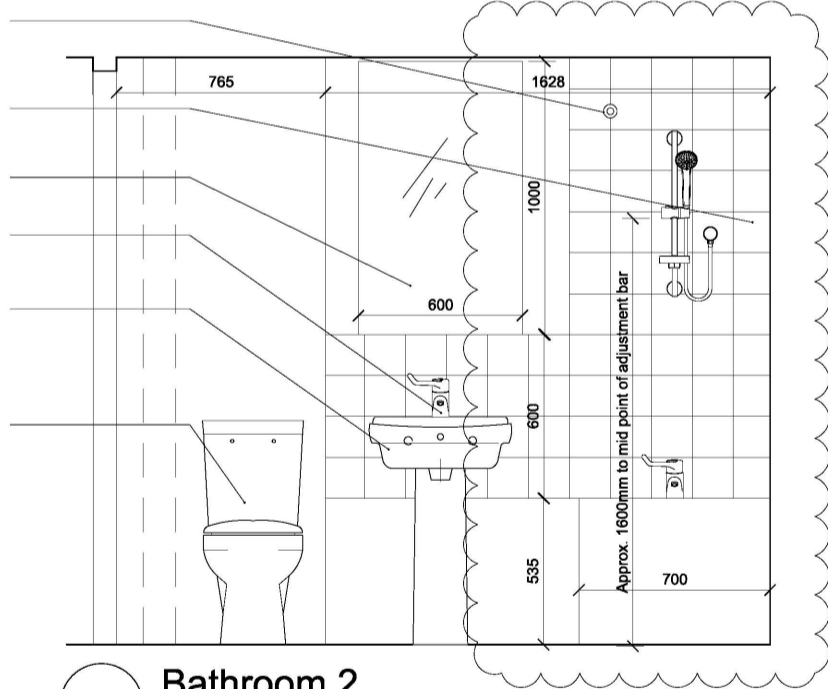

5 Bathroom 2
1:20

- SHOWER CURTAIN RAIL N13 - 375C
- SHOWER HEAD with THERMOSTATIC MIXER N13 - 375
- TILING M40 - 112
- TAP MIXER N13 - 335A
- WASHBASIN PEDESTAL UNIT N13 - 335A

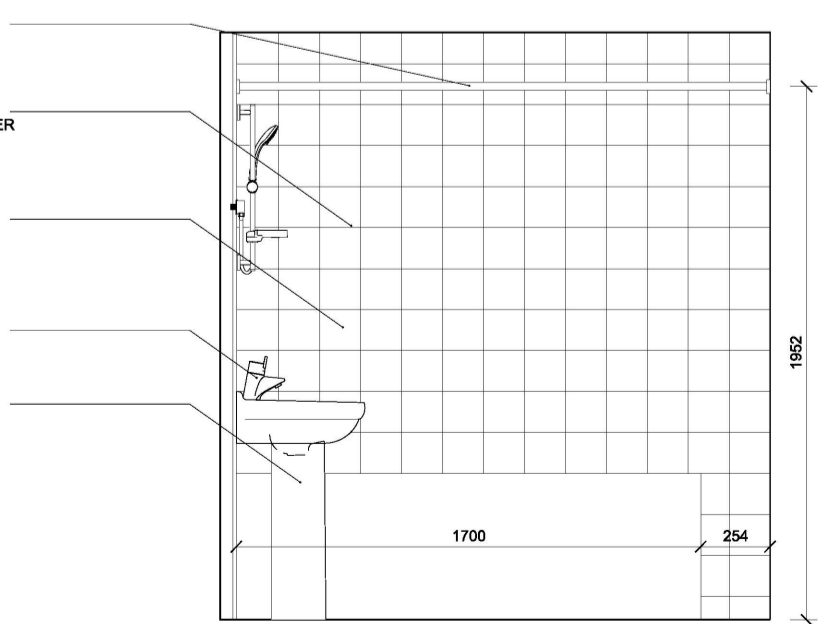

6 Bathroom 3
1:20

- NOTE
1. THIS DRAWING IS COPYRIGHT STUDIO E LLP
 2. THE CONTRACTOR MUST NOT SCALE FROM THE DRAWING ALL DIMENSIONS TO BE TAKEN FROM DIMENSION STRINGS
 3. WHERE ANY DISCREPANCIES ARE FOUND BETWEEN DIMENSIONS THESE MUST BE BROUGHT TO THE ATTENTION OF THE ARCHITECTS FOR RESOLUTION.
 4. WHERE DISCREPANCIES EXIST BETWEEN REFERENCE OR ASSEMBLY DRAWINGS & DETAIL DRAWINGS, THE LATTER TAKE PREFERENCE.

04	20/02/15	Comments incorporated
03	27/01/15	Service Modifications
02	06/01/15	Units/ Sink Position Tweaked
01	22/12/14	Updated Layouts/ Electrical
00	12/11/13	Employers Requirements



AS BUILT

STUDIO E ARCHITECTS LTD
 310 Linton House, 164/180 Union Street
 London SE1 0LH

GRENfell TOWER
 REGENERATION PROJECT
 PROJECT

FLAT TYPE 3
 MEZZANINE 1 BED

DRAWING

1:20@A1	12/11/13
SCALE	DATE
1279 (04) 202	04
DWG. NO.	ISSUE
	CHECKED