


TMOM000000063/1
TMOM000000063_0001

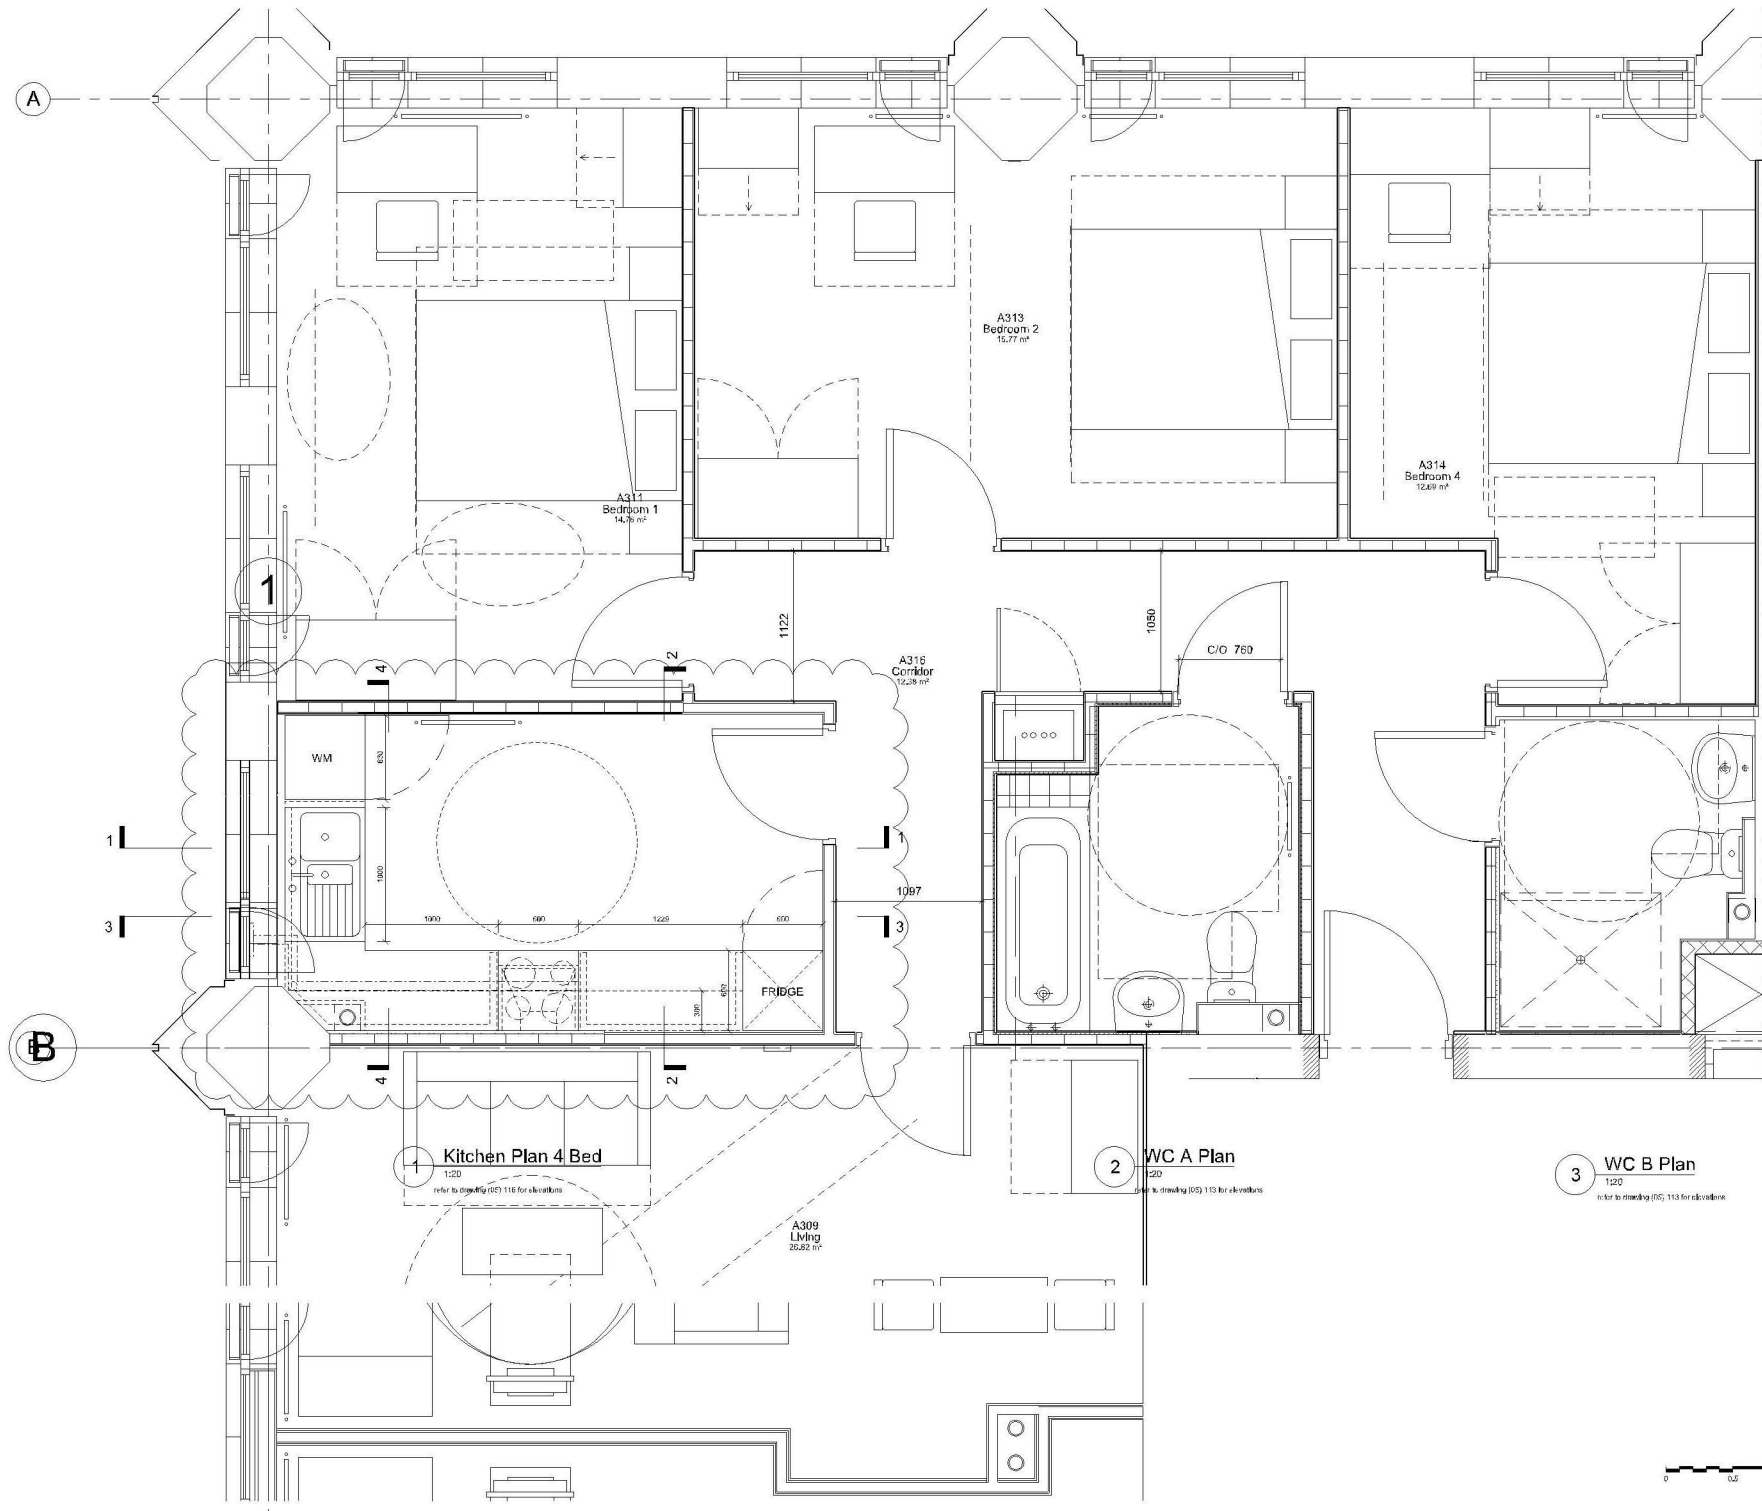

NOTES:

1. THE DRAWING IS COPYRIGHT © STUDIO E A.P.
2. THE CONTRACTOR MUST NOT SCALE FROM THE DRAWING. ALL DIMENSIONS TO BE TAKEN FROM THE DIMENSION LINES.
3. THERE ARE ANY DISCREPANCIES BETWEEN THE DRAWING AND THE PROJECT INFORMATION, THE DRAWING SHALL PREVAIL.
4. THERE ARE DISCREPANCIES BETWEEN THE DRAWING AND THE PROJECT INFORMATION, THE DRAWING SHALL PREVAIL.

01 05/07/14 Bill Poulton Treated

02 12/11/13 Employee Handwritten

AS BUILT

STUDIO E ARCHITECTS LTD

170 Little Venice, W2 1AD London Street
London W2 1AD

GRENfell TOWER
REGENERATION PROJECT

FLAT TYPE 6
WALKWAY #1
4 BED
LIVING

12/08/11 12/11/13

SCALE DATE

1279 (04) 205 01

REF. CL. BRUF. CAROFF.