


2 Elevation A
1:20

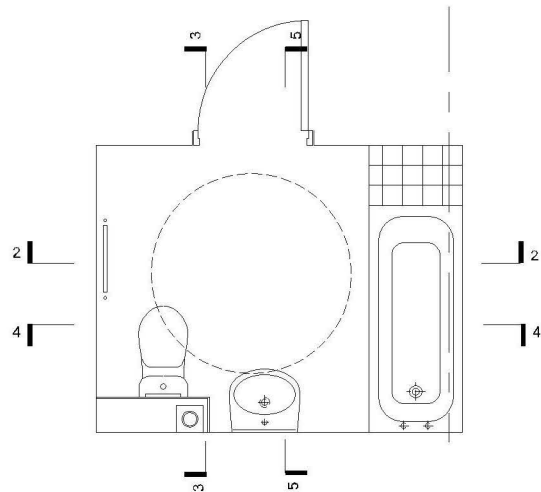

1 Accessible WC Plan
1:20

Shower
N13 - 375

Shower
N13 - 375


Tap
N13 - 335A

Washbasin Pedestal
N13 - 335A

W/Cs & Cisterns
N13 - 300A

Bath
N13 - 355A

3 Elevation B
1:20

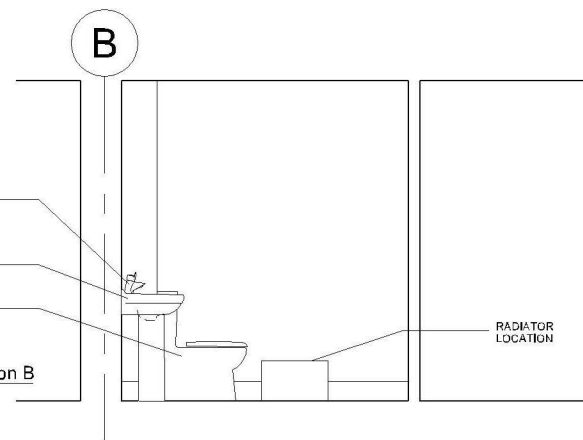


Curtain Rail
N13 - 375C

Mirror
N10 - 270

Shower
N13 - 375

Tiling
M40/112

4 Elevation C
1:20

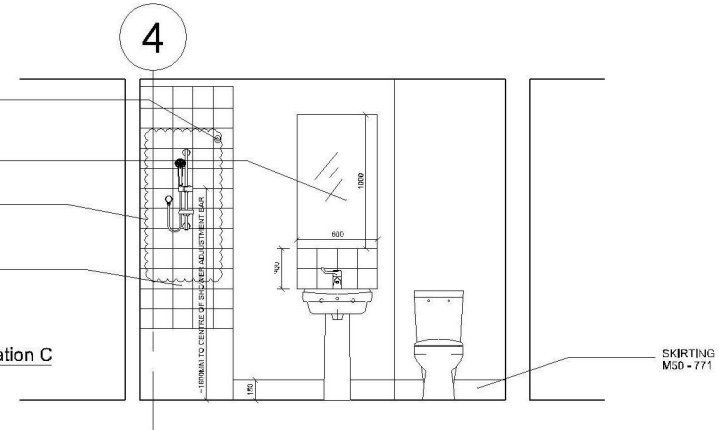

Curtain Rail
N13 - 375C


Shower
N13 - 375

Washbasin Pedestal
N13 - 335A

Tiling
M40/112

Bath
N13 - 355A

5 Elevation D
1:20

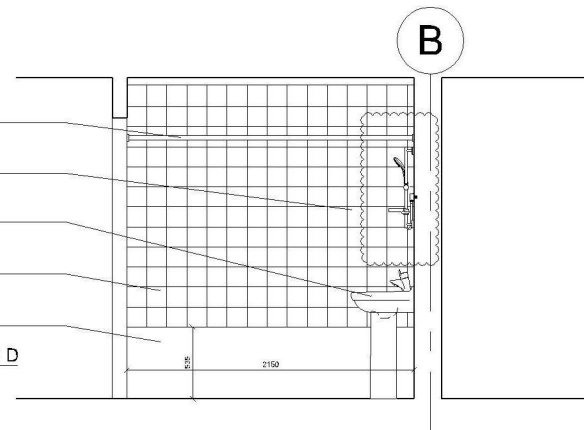

- NOTES:
1. THIS DRAWING IS COPYRIGHT © STUDIO E ARCHITECTS LTD.
 2. THE CONTRACTOR MUST NOT SCALE FROM THE DRAWING. ALL DIMENSIONS TO BE TAKEN FROM THE DIMENSIONS ON THE DRAWING.
 3. THERE ARE ANY DISCREPANCIES BETWEEN THE DRAWING AND THE ACTUALITY, THE ACTUALITY SHALL PREVAIL.
 4. THERE ARE ANY DISCREPANCIES BETWEEN THE DRAWING AND THE ACTUALITY, THE ACTUALITY SHALL PREVAIL.

02	20/09/15	Comments Incorporated
01	25/09/15	Services Update



AS BUILT

STUDIO E ARCHITECTS LTD

270 Little Venice, NW1 6AU London United Kingdom

GRENfell TOWER REGENERATION PROJECT

Resi Bathrooms Accessible WC

UNIFORM

1:20 @ A1 13/11/13

SCALE DATE

1279 (05) 14 02

REF. CL. DESIG. CHECKED