




1 Kitchen Elevation 1
1:20

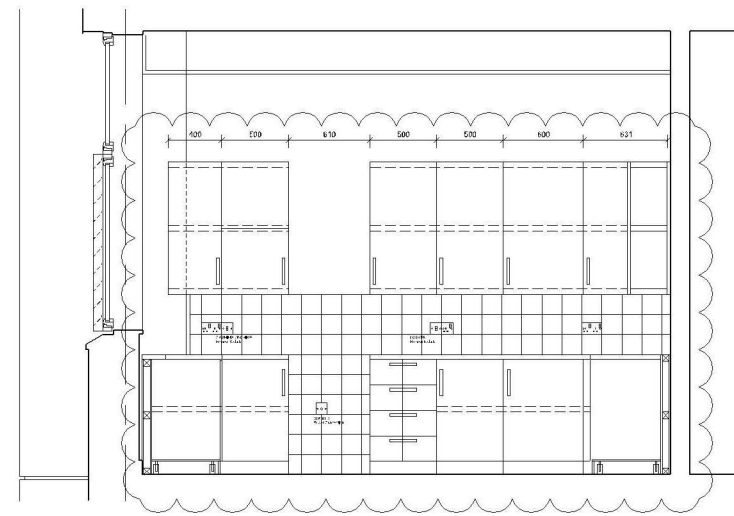


2 Kitchen Elevation 2
1:20

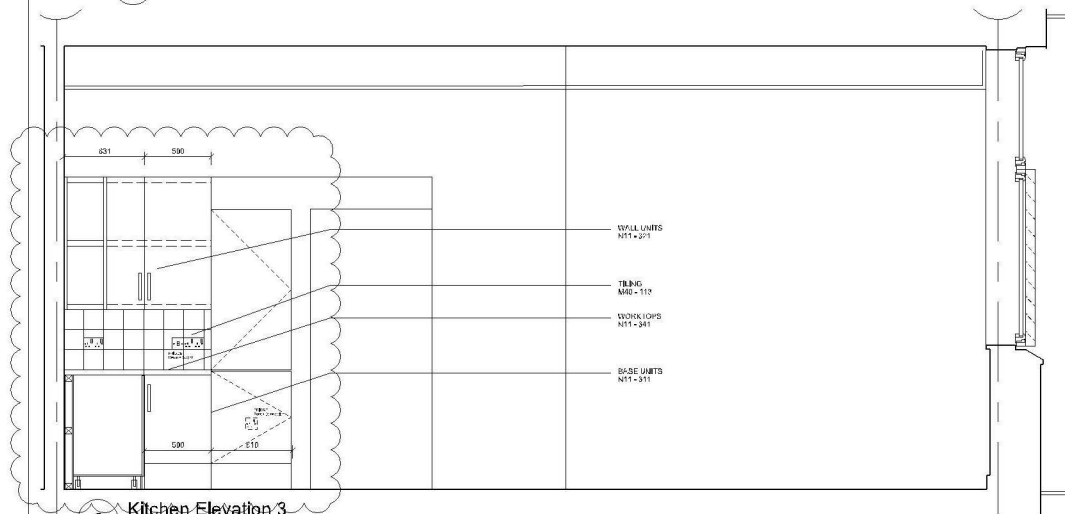


3 Kitchen Elevation 3
1:20

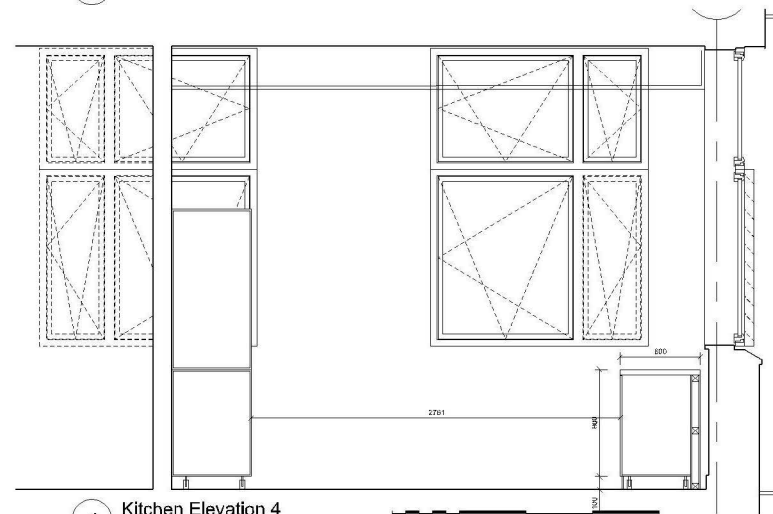


4 Kitchen Elevation 4
1:20

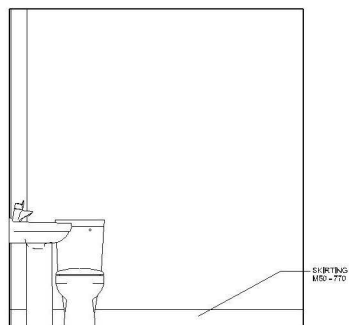


5 Bathroom Elevation 1
1:20

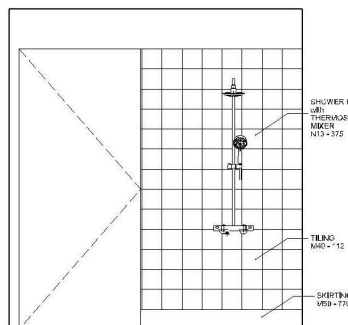

6 Bathroom Elevation 2
1:20

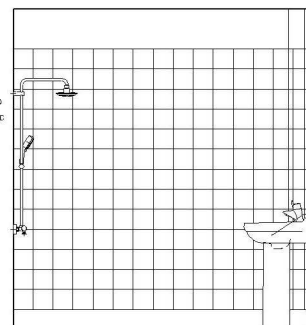

7 Bathroom Elevation 3
1:20

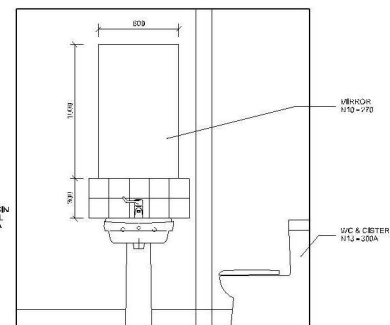

8 Bathroom Elevation 4
1:20

- NOTES
1. THE DRAWING IS COPYRIGHT © STUDIO E A.P.
 2. THE CONTRACTOR MUST NOT SCALE FROM THE DRAWING. ALL DIMENSIONS TO BE TAKEN FROM THE DIMENSION LINES.
 3. THERE ARE ANY DISCREPANCIES BETWEEN THE DRAWING AND THE CONTRACT DOCUMENTS, THE CONTRACTOR MUST BE RESPONSIBLE FOR THE DISCREPANCY.
 4. THERE ARE DISCREPANCIES BETWEEN THE DRAWING AND THE CONTRACT DOCUMENTS, THE CONTRACTOR MUST BE RESPONSIBLE FOR THE DISCREPANCY.

04	12/09/15	Kitchen Update
05	20/09/15	Comments Incorporated
06	01/10/15	SBK Finalised
07	21/10/14	Updated Layout Electrical
08	12/11/14	Employer Requirements



AS BUILT

STUDIO E ARCHITECTS LTD

270 Little Venice, W2 1AD London

GRENFELL TOWER

REGENERATION PROJECT

RESIDENTIAL FLAT ELEVATIONS

UNIFORM

12/09/15 12/11/13

SCALE DATE

12/09/15 12/11/13

FILE CL. DES. CARCOP