




1. T.M.O. (T.M.O. 000000072/1)
 2. T.M.O. (T.M.O. 000000072/1)
 3. T.M.O. (T.M.O. 000000072/1)
 4. T.M.O. (T.M.O. 000000072/1)
 5. T.M.O. (T.M.O. 000000072/1)

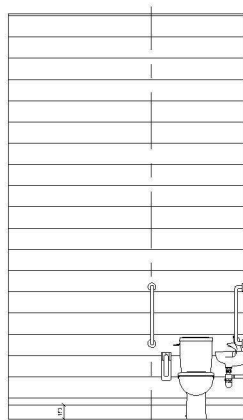


2 Elevation A - WW

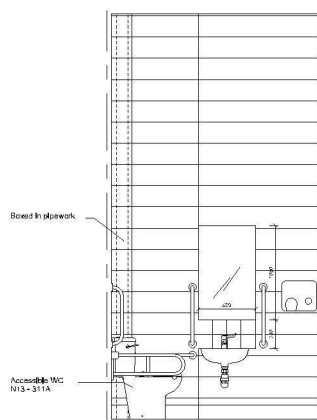


3 Elevation B - WW

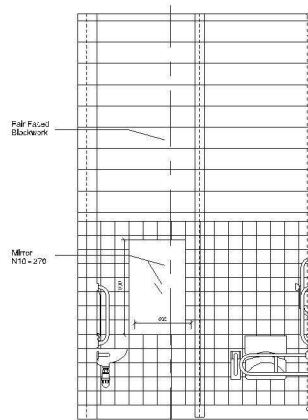

4 Elevation C - WW

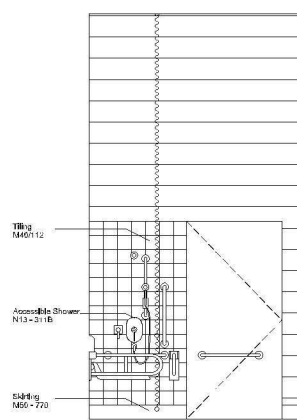

5 Elevation D - WW

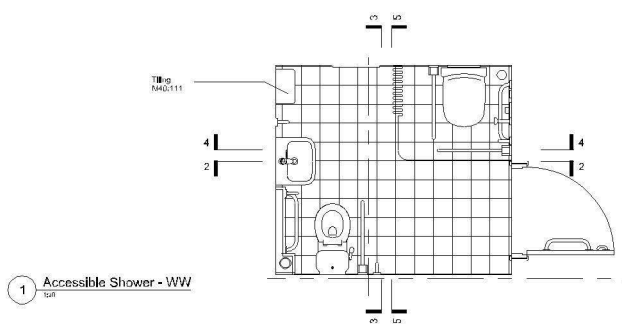

1 Accessible Shower - WW



AS BUILT

STUDIO E ARCHITECTS LTD

GREENFELL TOWER

REFURBISHMENT PROJECT

Accessible Shower

Boiling Club

12/06/2017

13/11/2017

12/06/2017

13/11/2017

