
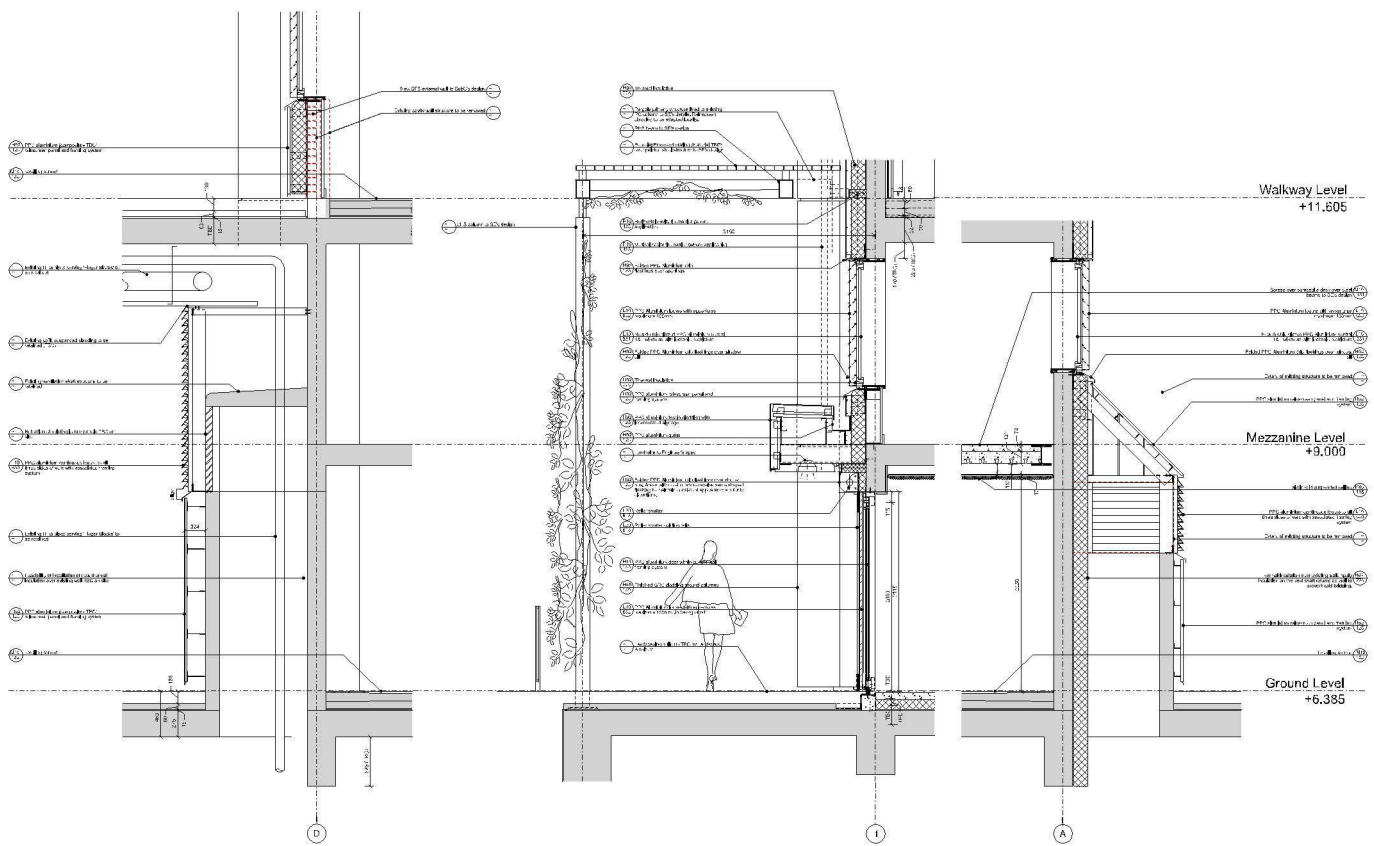


NOTES:
 1. ALL CONSTRUCTION SHALL BE IN ACCORDANCE WITH THE LATEST EDITIONS OF THE BRITISH STANDARDS INSTITUTION (BSI) STANDARDS.
 2. ALL MATERIALS SHALL BE OF THE HIGHEST QUALITY AND SHALL BE SUBMITTED FOR APPROVAL BY THE ARCHITECT.
 3. ALL WORK SHALL BE COMPLETED WITHIN THE SPECIFIED TIME FRAME.
 4. ALL WORK SHALL BE COMPLETED TO THE SATISFACTION OF THE ARCHITECT.

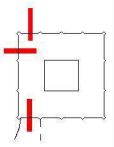

1 Proposed Section through Existing Bridge Link
1/9

2 Proposed Section through Nursery Entrance Canopy
1/9

3 Proposed Section through Basement Ventilation Shaft
1/9

AS BUILT
 STUDIO E ARCHITECTS LTD
 1279 (C) 122 (C)
 GREENFELL TOWER
 REGENERATION PROJECT
 DETAIL SECTIONS
 SHEET 3
 1279 (C) 122 (C)
 1279 (C) 122 (C)
 1279 (C) 122 (C)