

1. THIS DRAWING IS COPYRIGHT STUDIED E ILL.
2. THE DIMENSIONS MUST NOT SCALE TO BE TAKEN FROM DIMENSION LINES.
3. WHERE ANY DISCREPANCIES ARE FOUND BETWEEN THE DIMENSIONS, THE DIMENSIONS MUST BE BROUGHT FORWARD TO THE ATTENTION OF THE ARCHITECTS FOR RESOLUTION.
4. WHERE DISCREPANCIES EXIST BETWEEN REFERENCE ON ASSEMBLY, DRAWINGS & DETAIL DRAWINGS, THE LATTER TAKE PRECEDENCE.

No.	Description	Date
	2 Bed App. change 3 to 4 Person	25/02/15
	Mechanical AOV Modified Door rating	27/01/15
	New Fit Updated Kitchen Layouts Updated	06/01/15
	Layouts Updated to refined BC Fire Meeting	28/11/14
	Layouts finalised, door numbers rationalised	13/11/14



AS BUILT

STUDIO **E** ARCHITECTS

Journal of Management Education 35(1)

SCREENFILL TOWER


2000

Setting Out Plan Mezzanine

Journal of Management Education

2072

1279 (22) 102 08

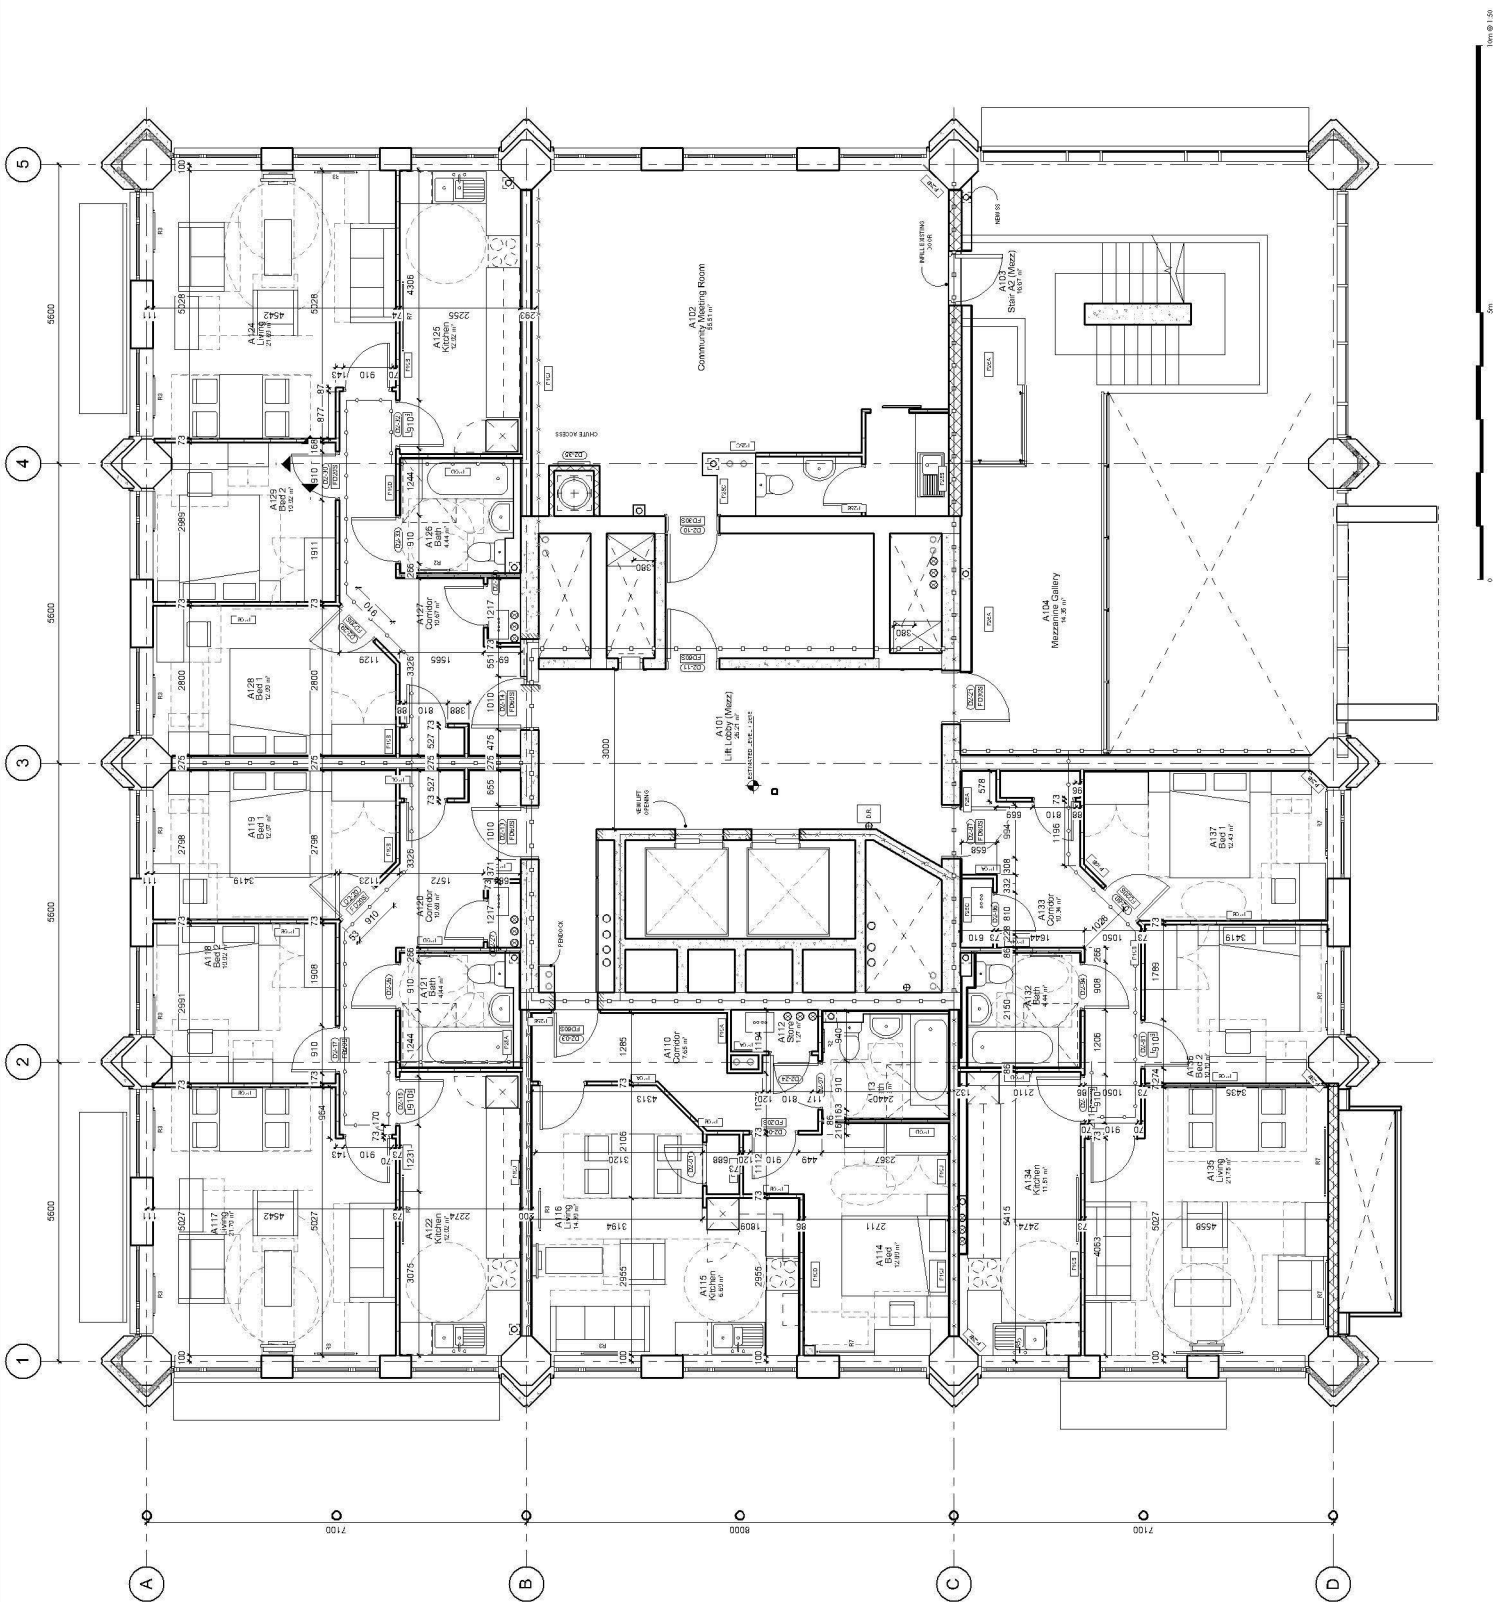

Tom @ 1:50

TMOM00000081/1