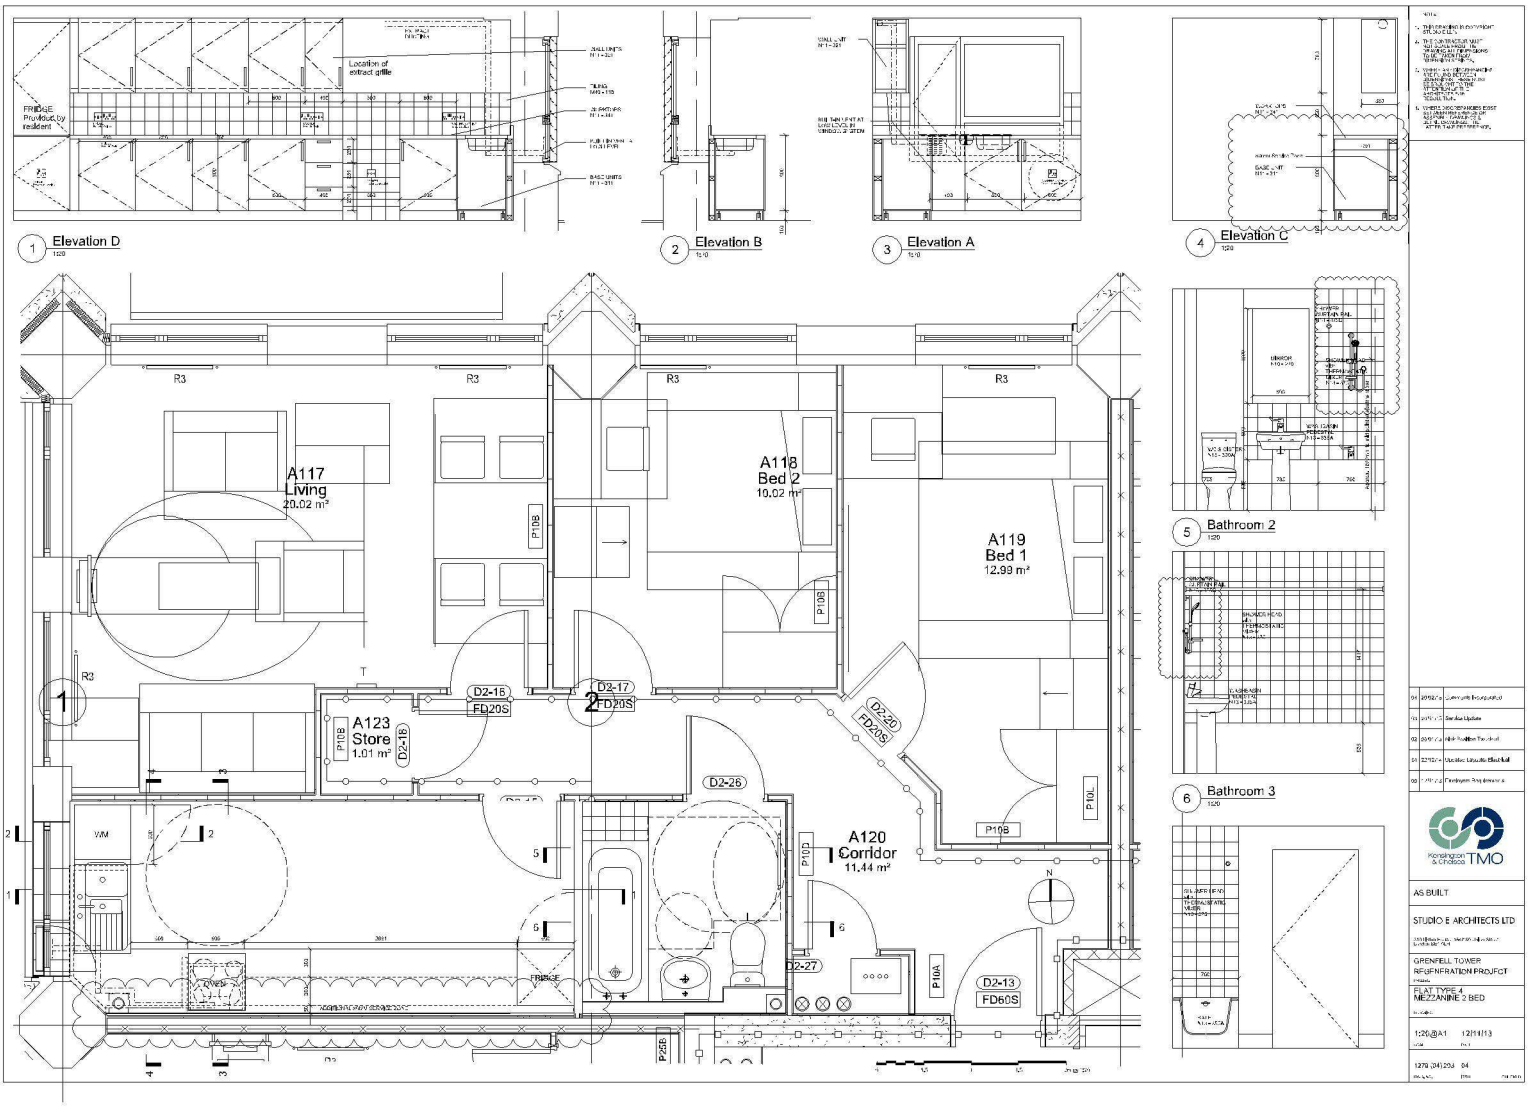
1 Elevation D
2 Elevation B
3 Elevation A
4 Elevation C
5 Bathroom 2
6 Bathroom 3
A117 Living 20.02 m²
A118 Bed 2 10.02 m²
A119 Bed 1 12.99 m²
A120 Corridor 11.44 m²
A123 Store 1.01 m²
AS BUILT
STUDIO E ARCHITECTS LTD
GRENFELL TOWER REGENERATION PROJECT
FLAT TYPE 4 MEZZANINE 2 BED