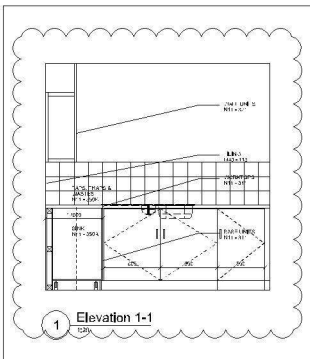

1 Elevation 1-1
1:20

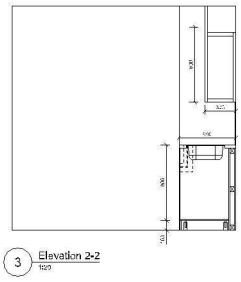

3 Elevation 2-2
1:20

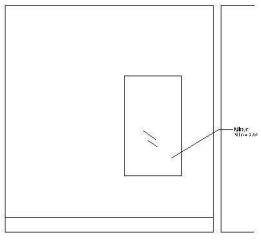

5 Elevation 5-5
1:20

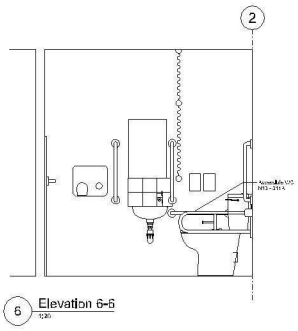

6 Elevation 6-6
1:20

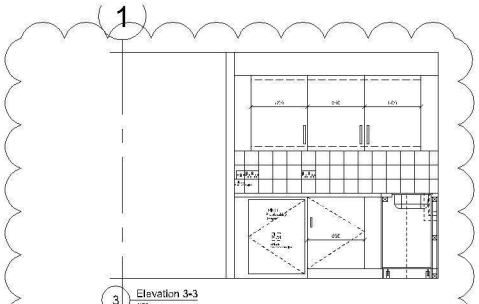

3 Elevation 3-3
1:20

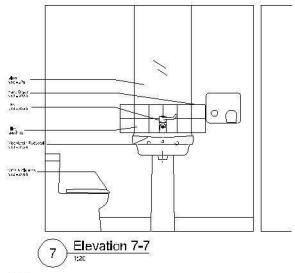

7 Elevation 7-7
1:20

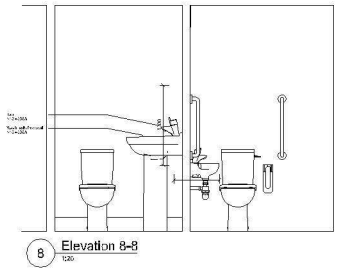

8 Elevation 8-8
1:20

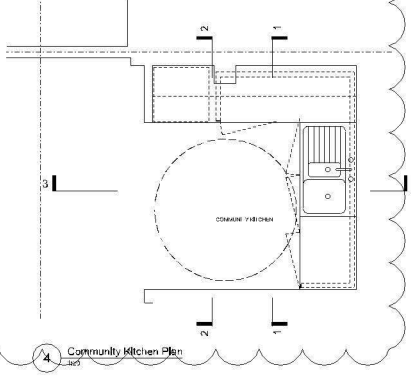

4 Community Kitchen Plan
1:20

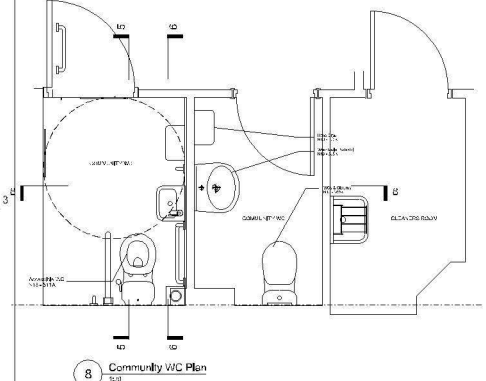

8 Community WC Plan
1:20

AS BUILT

STUDIO E ARCHITECTS LTD

GRENFELL TOWER REGENERATION PROJECT

Community WC/ Kitchen Ground Level

1:20@A1 07/04/15

1270 (00)059 02