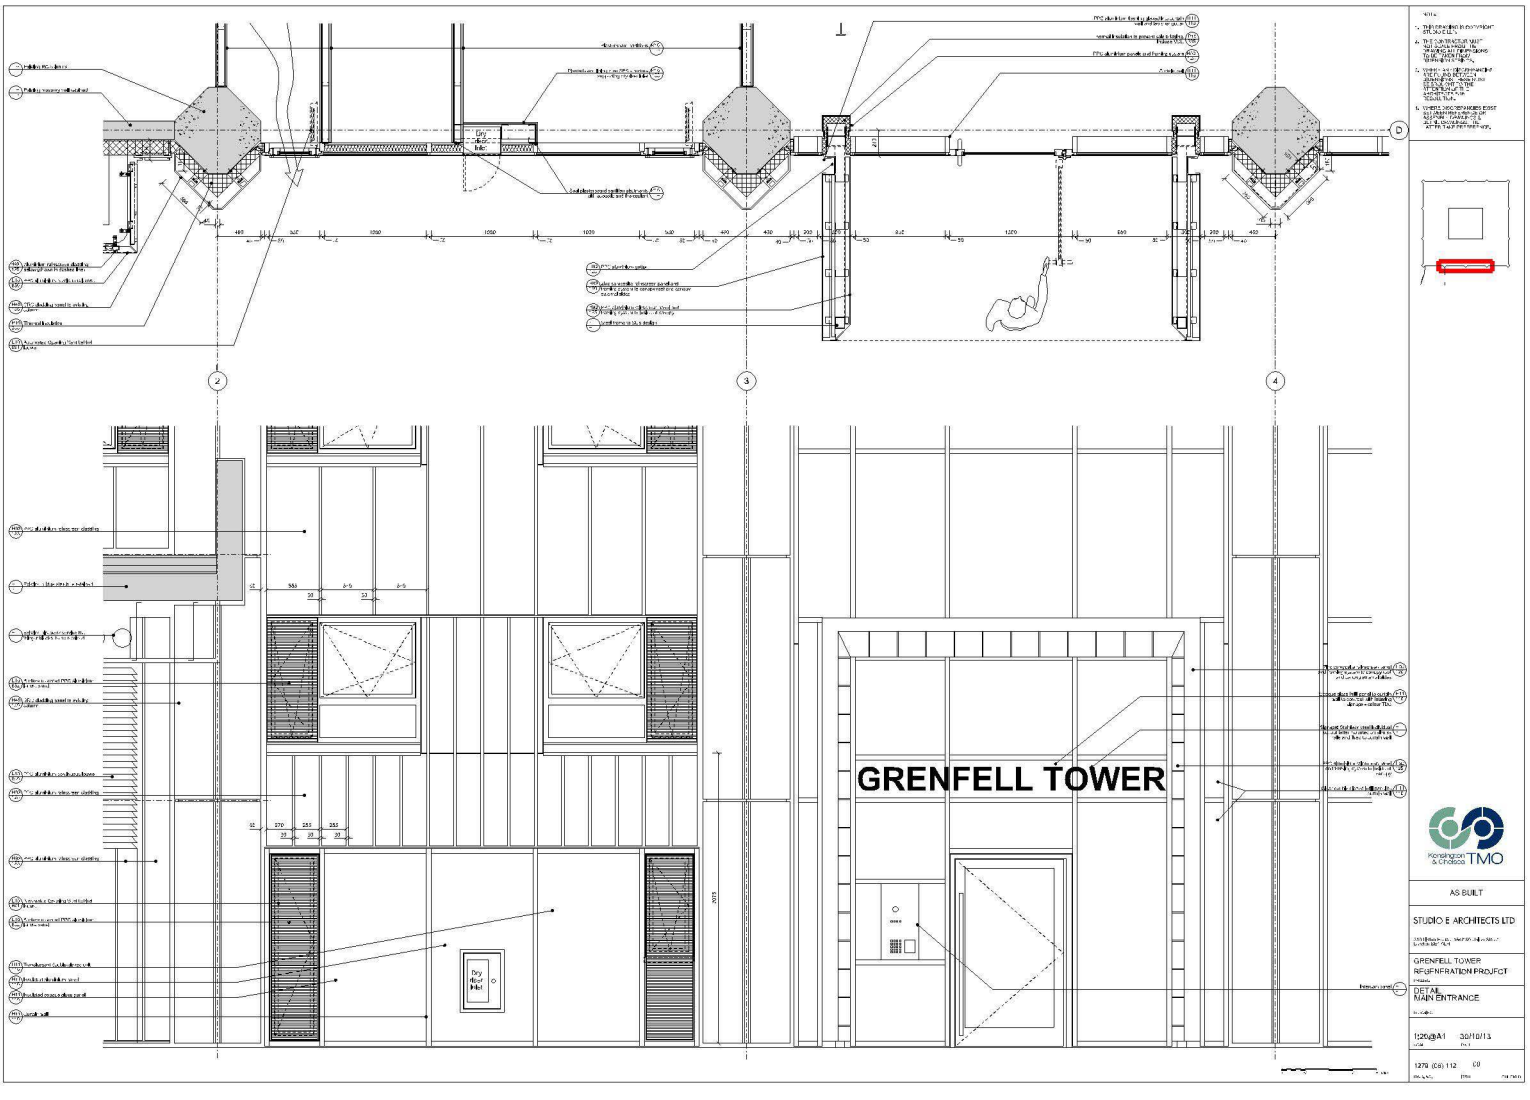
GRENFELL TOWER
Kensington & Chelsea TMO
AS BUILT
STUDIO E ARCHITECTS LTD
GRENFELL TOWER
REGENERATION PROJECT
DETAIL
MAIN ENTRANCE
1:20@A1
30/10/13
1278 (08) 112
00