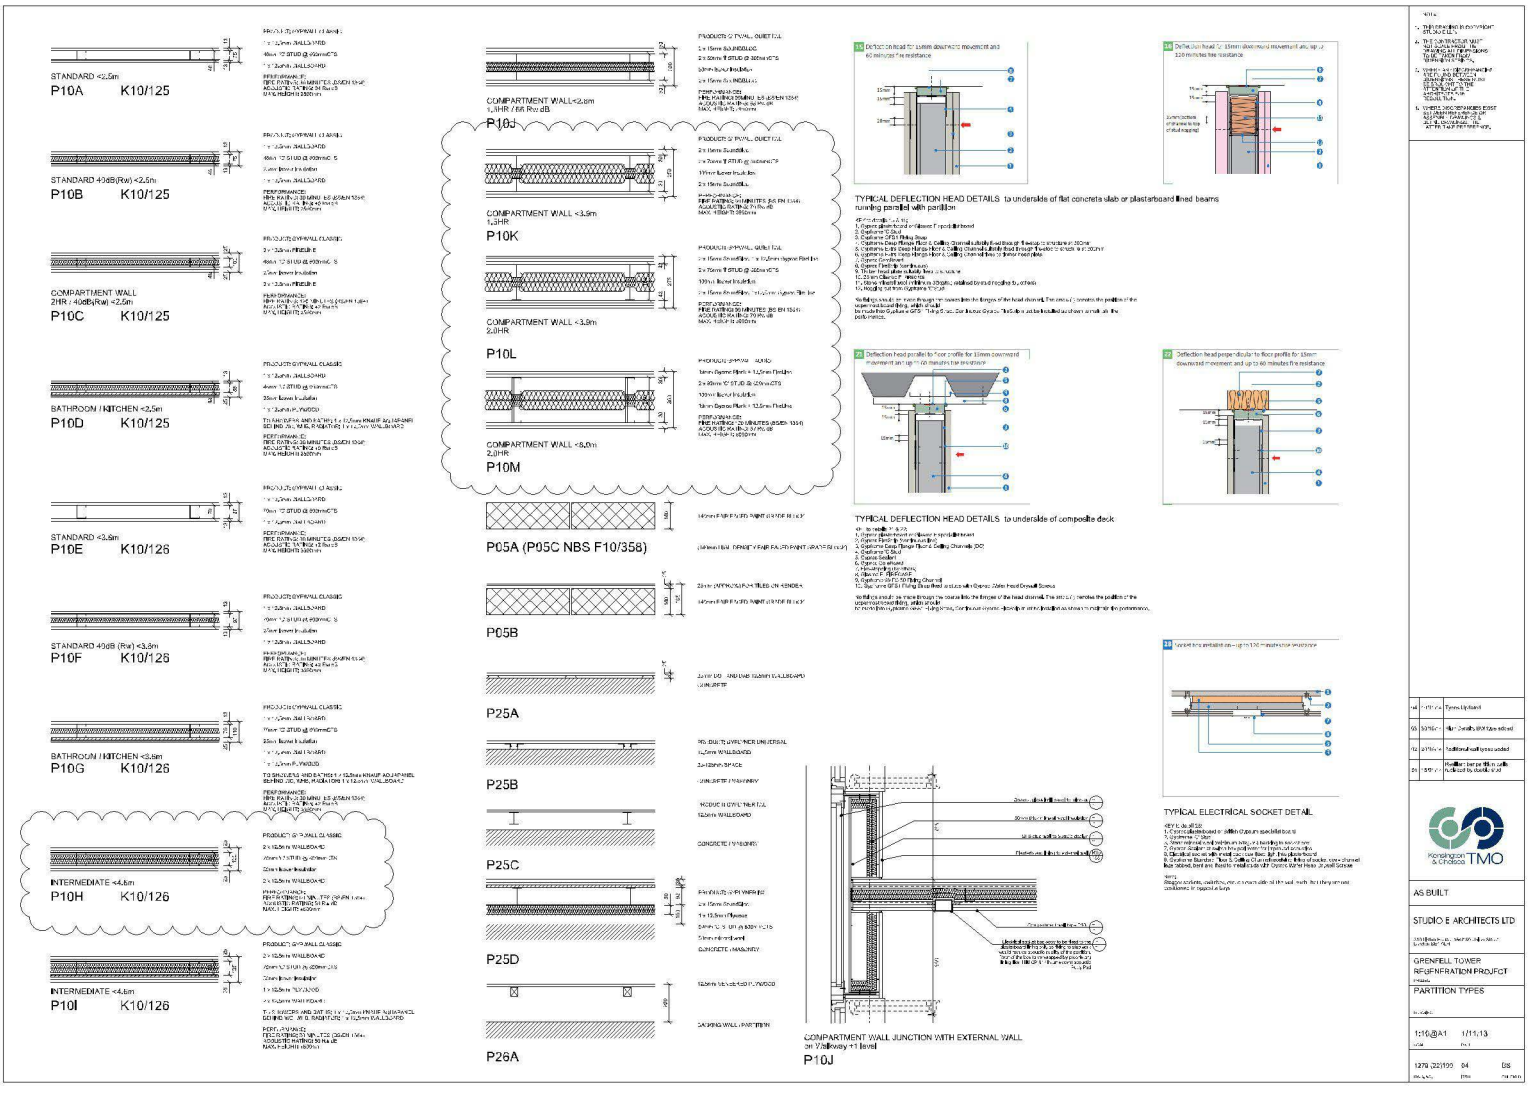

AS BUILT

STUDIO E ARCHITECTS LTD

GRENFELL TOWER
REGENERATION PROJECT

PARTITION TYPES

1:10 @ A1 1/11/13

1279 (22)100 04

TMOM00000079/1

TMOM00000079_0001