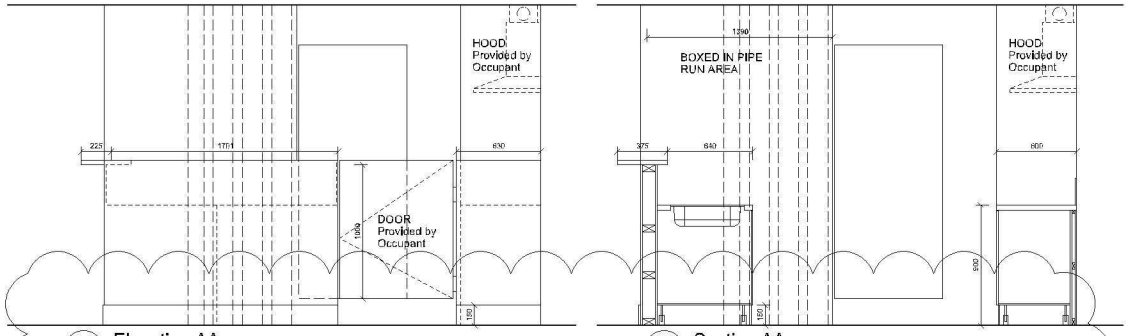

3 Elevation AA
1:20

4 Section AA
1:20

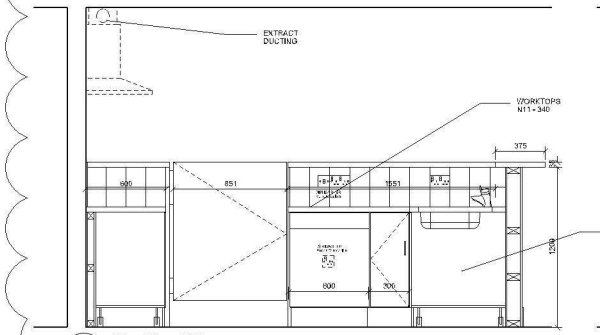

2 Section BB
1:20

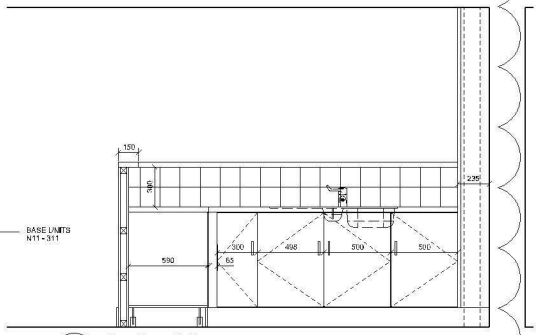

5 Section CC
1:20

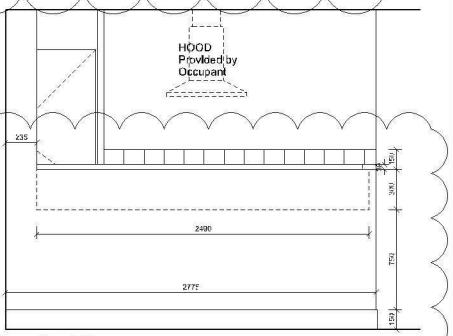

6 Elevation BB
1:20

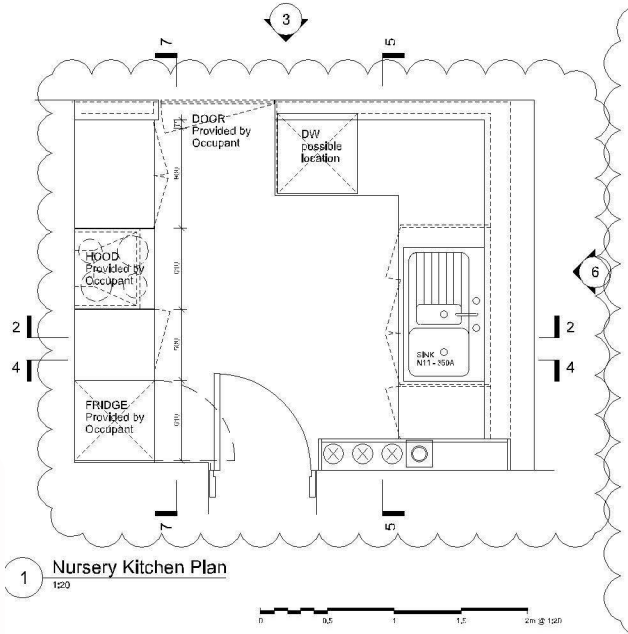

1 Nursery Kitchen Plan
1:20

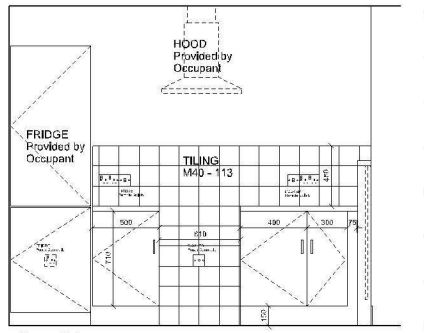

7 Section DD
1:20

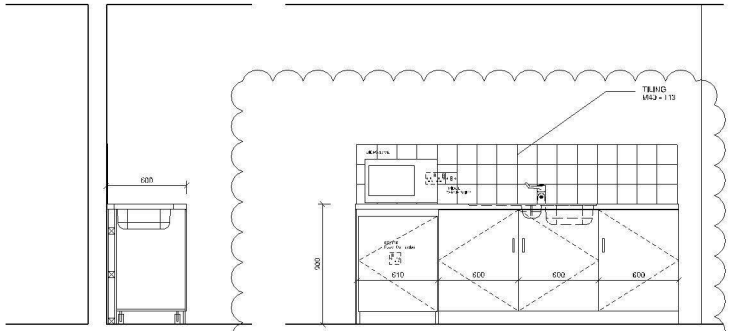

12 Sink Worktop Section
1:20

13 Sink Worktop Elevation
1:20

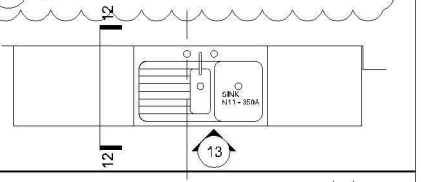

11 Sink Worktop Plan
1:20

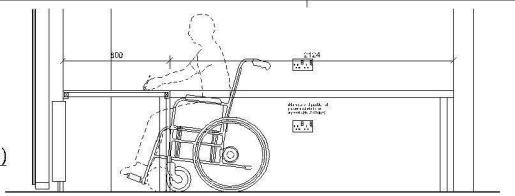

10 Worktop Section (office)
1:20

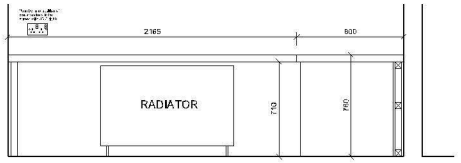

9 Worktop Elevation (office)
1:20

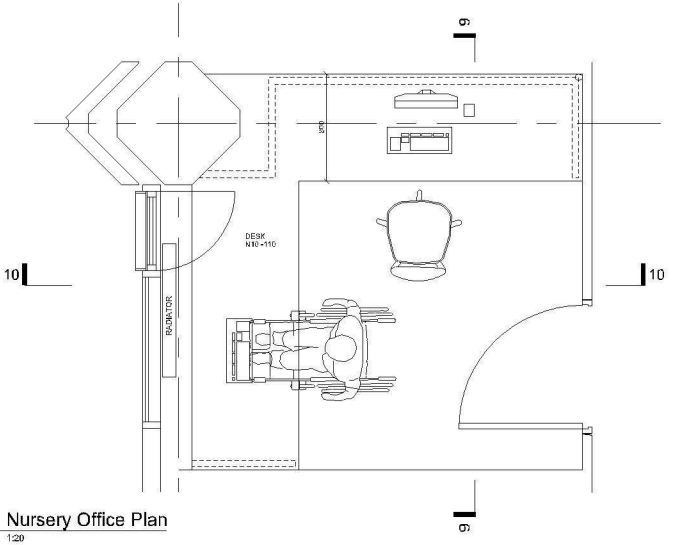

8 Nursery Office Plan
1:20

NOTE:

1. THIS DRAWING IS COPYRIGHT STUDIO E LLP.
2. THE CONTRACTOR MUST NOT SCALE FROM THE DRAWING ALL DIMENSIONS TO BE TAKEN FROM DIMENSION STRINGS.
3. WHERE ANY DISCREPANCIES ARE FOUND BETWEEN DIMENSIONS THESE MUST BE BROUGHT TO THE ATTENTION OF THE ARCHITECTS FOR RESOLUTION.
4. WHERE DISCREPANCIES EXIST BETWEEN REFERENCE OR ASSEMBLY DRAWINGS & DETAIL DRAWINGS, THE LATTER TAKE PREFERENCE.

01	12/06/15	General Update
00	14/11/14	Employers Requirements

Kensington & Chelsea TMO

AS BUILT

STUDIO E ARCHITECTS LTD

3rd Floor Heron, 65/140 Union Street London SE1 0LH

GRENFELL TOWER REGENERATION PROJECT

NURSERY KITCHEN AND OFFICE

1:20@A1	28/10/13
SCALE	DATE
1279 (72) 101	01
DWG. NO.	ISSUE
	BS
	CHECKED

TMOM00000981

TMOM00000098_0001